


North

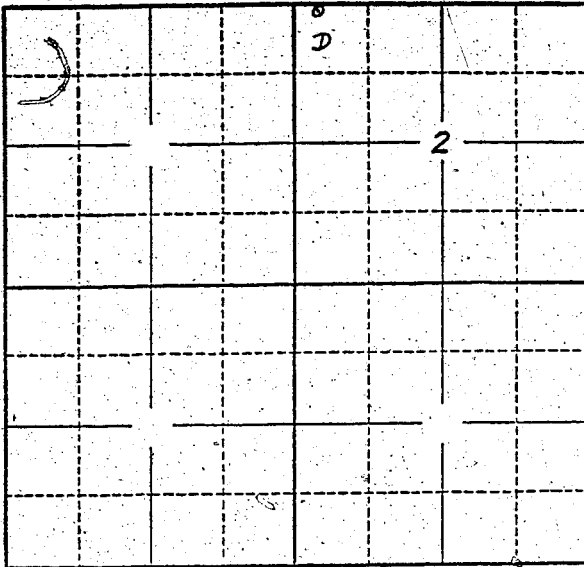

Locate well and acreage of irrigated land on plat.

Scale: 2" = 1 Mile

STATE OF OREGON

County of Marion } ss.

I, Lee H. Thompson  
Lee H. Thompson, being first duly sworn, do hereby certify that I have read the foregoing Registration Statement and that all of the items therein contained are true to the best of my knowledge and belief.

Lee H. Thompson  
Lee H. Thompson  
(Signature of Registrant)

Subscribed and sworn to before me this 24<sup>th</sup> day of June, 1958.

My commission expires Sept. 8, 1960 Charles [Signature]  
(Notary Public)

(SEAL)

**CERTIFICATE OF REGISTRATION**

STATE OF OREGON } ss.  
County of Marion

This is to certify that the foregoing Registration Statement was received in the office of the State Engineer on the 24<sup>th</sup> day of June, 1958, at 9:30 o'clock A. M. and has been duly recorded in said office in Book No. 8 of Registration Statements on page GR-1725

Witness my hand this 17<sup>th</sup> day of January, 1959  
Lewis A. Stanton  
(State Engineer)

By \_\_\_\_\_ (Deputy)

\$15.00