


North

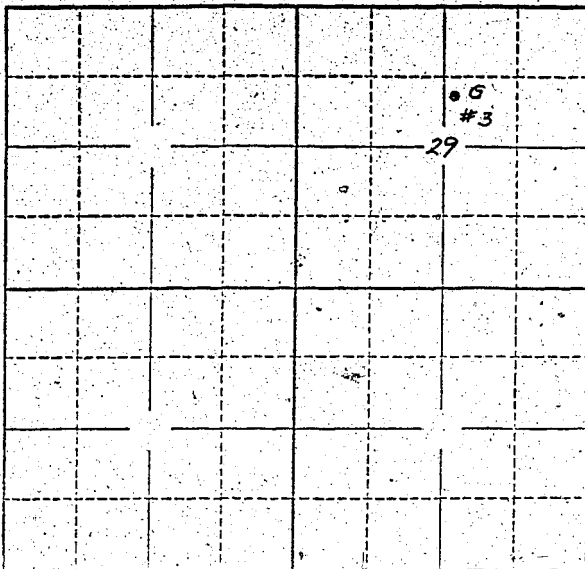

Locate well and acreage of irrigated land on plat.

Scale: 2" = 1 Mile

STATE OF OREGON

County of Lane } ss.

Howard Myers, being first duly sworn, do hereby certify that I have read the foregoing Registration Statement and that all of the items therein contained are true to the best of my knowledge and belief.

Howard Myers  
(Signature of Registrant)

Subscribed and sworn to before me this 21<sup>st</sup> day of June, 1958.

My commission expires \_\_\_\_\_  
(Notary Public)

(SEAL)

**CERTIFICATE OF REGISTRATION**

STATE OF OREGON }  
County of Marion } ss.

This is to certify that the foregoing Registration Statement was received in the office of the State Engineer on the 25<sup>th</sup> day of June, 1958, at 8:00 o'clock A. M. and has been duly recorded in said office in Book No. 8 of Registration Statements on page GR-1742

~~Construction shall be completed by \_\_\_\_\_ and the water completely applied to \_\_\_\_\_~~

Witness my hand this 7<sup>th</sup> day of January, 1959  
Luvia A. Stanley  
(State Engineer)

By \_\_\_\_\_ (Deputy)

\$15.00