


Township 55 Range 3W W.M.
North

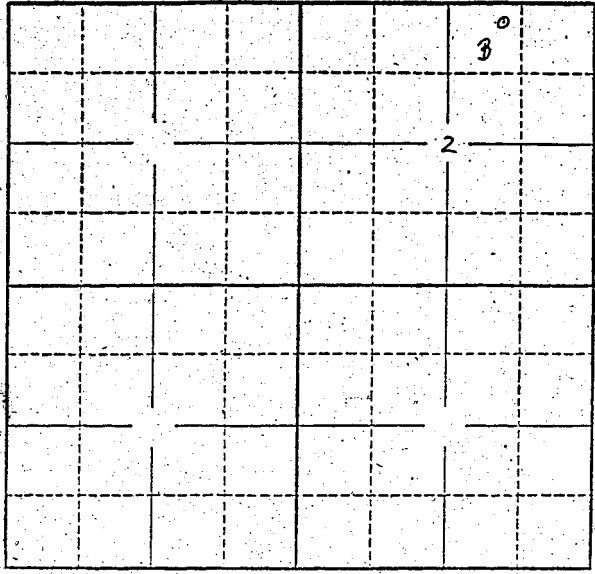

See atack map

Locate well and acreage of irrigated land on plat.
Scale: 2" = 1 Mile

STATE OF OREGON

County of Wamhill } ss.

I, Glen A. McFarlane, being first duly sworn, do hereby certify that I have read the foregoing Registration Statement and that all of the items therein contained are true to the best of my knowledge and belief.

Glen A. McFarlane
(Signature of Registrant)

Subscribed and sworn to before me this 15th day of February, 1958.

My commission expires May 23, 1960

Robert H. Lawrence
(Notary Public)

(SEAL)

CERTIFICATE OF REGISTRATION

STATE OF OREGON

County of Marion } ss.

This is to certify that the foregoing Registration Statement was received in the office of the State Engineer on the 25th day of June, 1958, at 8:00 o'clock A. M. and has been duly recorded in said office in Book No. 8 of Registration Statements on page GR-1747.

~~Construction shall be completed by 10 and the water completely applied to beneficial use by 10~~

Witness my hand this 7th day of January, 1959

Laura A. Stanley
(State Engineer)

By _____ (Deputy)

GR-1747

#26-65