


North

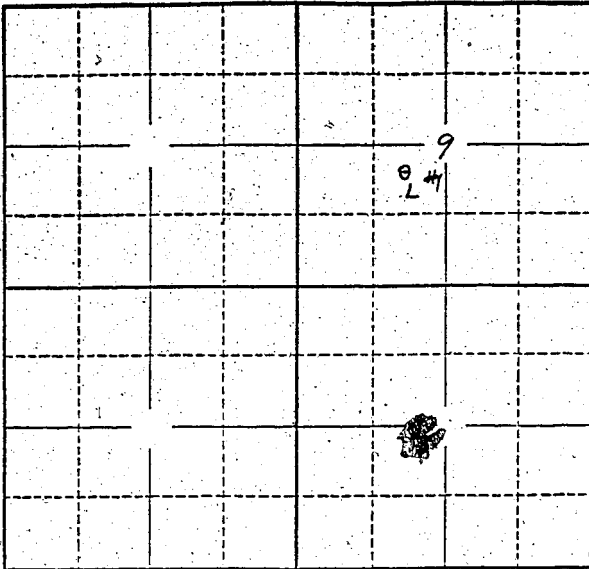

Locate well and acreage of irrigated land on plat.

Scale: 2" = 1 Mile

STATE OF OREGON

County of Linn } ss.

I, Sidney Hess, being first duly sworn, do hereby certify that I have read the foregoing Registration Statement and that all of the items therein contained are true to the best of my knowledge and belief.

Sidney Hess
(Signature of Registrant)

Subscribed and sworn to before me this 14th day of January, 1959.

My commission expires 2/2/59
(Notary Public)

(SEAL)

CERTIFICATE OF REGISTRATION

STATE OF OREGON }
County of Marion } ss.

This is to certify that the foregoing Registration Statement was received in the office of the State Engineer on the 26th day of June, 1958, at 8:00 o'clock A. M. and has been duly recorded in said office in Book No. 8 of Registration Statements on page GR-1755

Witness my hand this 7th day of January, 1959

Levon A. Stanley
(State Engineer)

\$15.00

By _____ (Deputy)