


8 13

Township 10 S Range 3 W W.M.

North

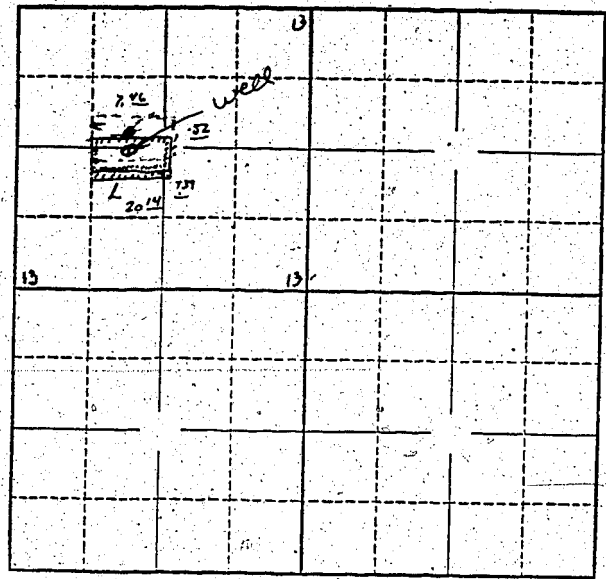

30A
ALL IRRIGATED

Locate well and acreage of irrigated land on plat.

Scale: 2" = 1 Mile

STATE OF OREGON

County of MARION } ss.

I, Egon C. Hawk, being first duly sworn, do hereby certify that I have read the foregoing Registration Statement and that all of the items therein contained are true to the best of my knowledge and belief.

Egon C. Hawk
(Signature of Registrant)

Subscribed and sworn to before me this 24 day of June, 1958

My commission expires June 5 - 1962

Joseph H. Tinsley
(Notary Public)

(SEAL)

CERTIFICATE OF REGISTRATION

STATE OF OREGON } ss.
County of Marion

This is to certify that the foregoing Registration Statement was received in the office of the State Engineer on the 26th day of June, 1958, at 3:00 o'clock P.M. and has been duly recorded in said office in Book No. 8 of Registration Statements on page GR-1760

Witness my hand this 7th day of January, 1959

Lawrence A. Stanley
(State Engineer)

By _____
(Deputy)

\$15.00

GR-1760