


North

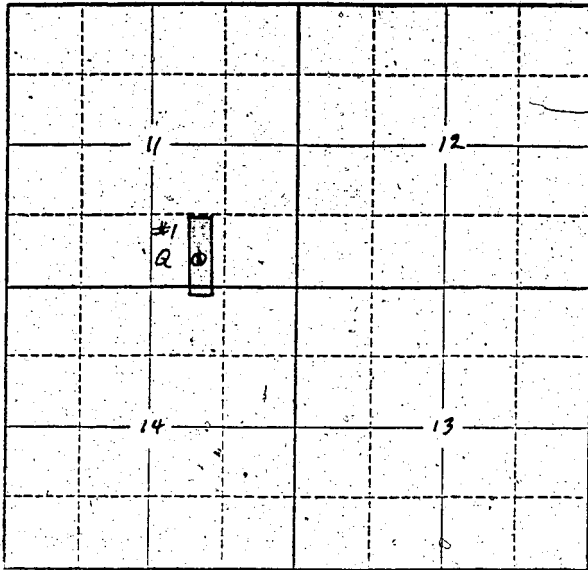

Locate well and acreage of irrigated land on plat.

Scale: 2" = 1 Mile

STATE OF OREGON

County of Linn } ss.

I, James E. Detering, being first duly sworn, do hereby certify that I have read the foregoing Registration Statement and that all of the items therein contained are true to the best of my knowledge and belief.

James E. Detering (Signature of Registrant)

Subscribed and sworn to before me this 14th day of March, 1958.

My commission expires August 13, 1958.

Wm. W. ... Notary Public for Oregon

(SEAL)

CERTIFICATE OF REGISTRATION

STATE OF OREGON } ss. County of Marion

This is to certify that the foregoing Registration Statement was received in the office of the State Engineer on the 27th day of June, 1958, at 8:00 o'clock A.M. and has been duly recorded in said office in Book No. 8 of Registration Statements on page GR-1770

Construction shall be completed by 1959 and the water completely applied to beneficial use by 1960

Witness my hand this 7th day of January, 1959.

Laura A. ... (State Engineer)

#1500

By (Deputy)

GR-1770