


Township 39S Range 7 West W.M. North

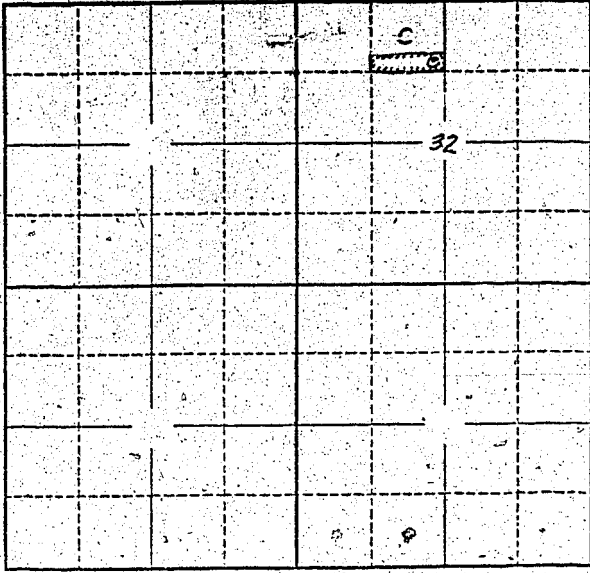

Locate well and acreage of irrigated land on plat.  
Scale: 2" = 1 Mile

STATE OF OREGON

County of Josephine } ss.

I, Alton E Sowell and Edith A. R. Sowell, being first duly sworn, do hereby certify that I have read the foregoing Registration Statement and that all of the items therein contained are true to the best of my knowledge and belief.

Alton E Sowell  
Edith A. R. Sowell  
(Signature of Registrant)

Subscribed and sworn to before me this 7th day of June, 1958.

My commission expires Sept 26 1958

Wessley Lloyd  
(Notary Public)

(SEAL)

**CERTIFICATE OF REGISTRATION**

STATE OF OREGON

County of Marion } ss.

This is to certify that the foregoing Registration Statement was received in the office of the State Engineer on the 27th day of June, 1958, at 8.00 o'clock A.M. and has been duly recorded in said office in Book No. 8 of Registration Statements on page GR-1775.

Witness my hand this 7th day of January, 1959

Lewis A. Stanley  
(State Engineer)

\$15.00

By \_\_\_\_\_ (Deputy)

GR-1775