


Township 14 S Range 2 W, W.M.
North

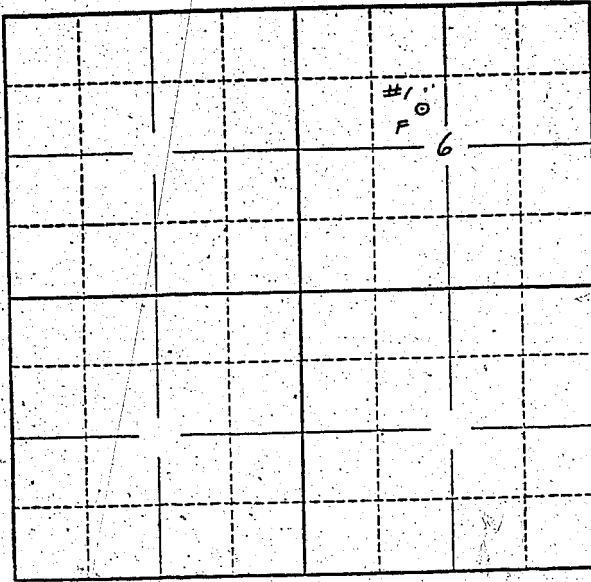

Locate well and acreage of irrigated land on plat.

Scale: 2" = 1 Mile

STATE OF OREGON

County of Linn } ss.

I, Ray and Barbara Cleland, being first duly sworn, do hereby certify that I have read the foregoing Registration Statement and that all of the items therein contained are true to the best of my knowledge and belief.

Ray Cleland
(Signature of Registrant)

Subscribed and sworn to before me this 25th day of June, 1958

My commission expires 2/18/59 Edward Carpenter
(Notary Public)

(SEAL)

CERTIFICATE OF REGISTRATION

STATE OF OREGON } ss.
County of Marion

This is to certify that the foregoing Registration Statement was received in the office of the State Engineer on the 27th day of June, 1958, at _____ o'clock _____ M. and has been duly recorded in said office in Book No. 8 of Registration Statements on page GR-1777

Witness my hand this 7th day of January, 1959

Lewis A. Standley
(State Engineer)


By _____ (Deputy)

GR - 1777

SECTION, R. 2W

RAY AND BARBARA CLELAND

16

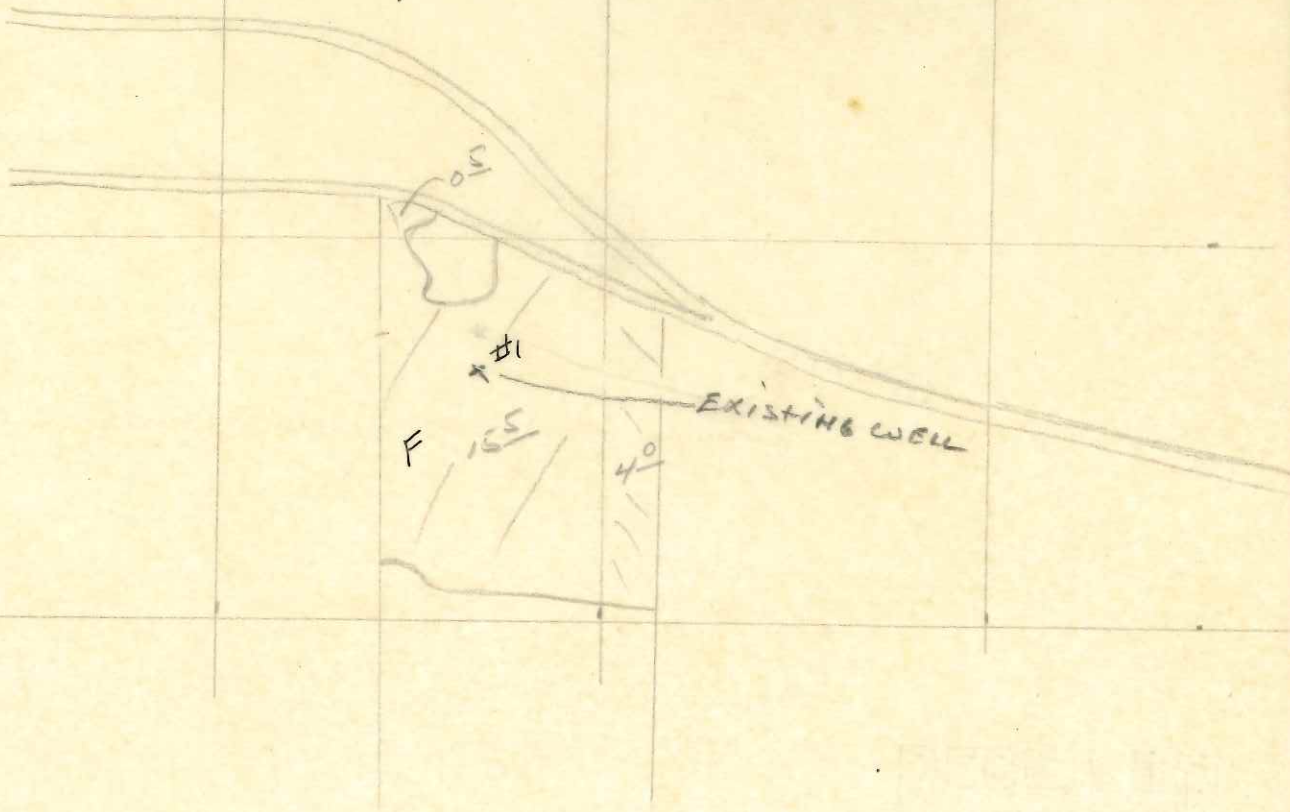

GR-1832