


North

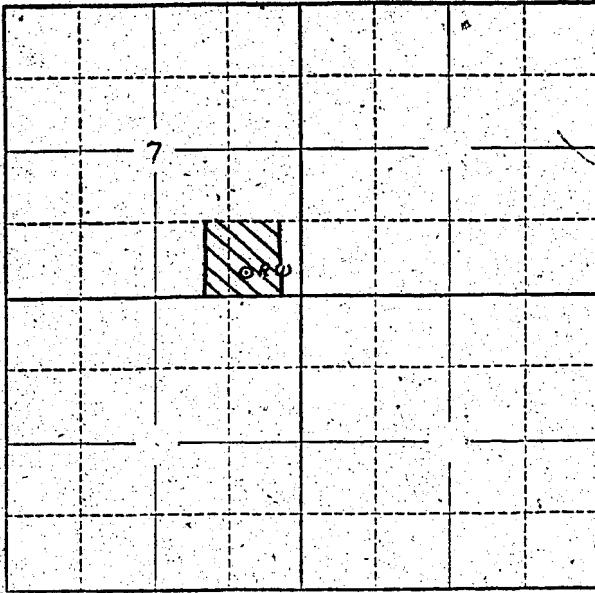

Locate well and acreage of irrigated land on plat.

Scale: 2" = 1 Mile

STATE OF OREGON

County of Linn } ss.

I, Henry H. and Edna M. Kirk, being first duly sworn, do hereby certify that I have read the foregoing Registration Statement and that all of the items therein contained are true to the best of my knowledge and belief.

Henry H. Kirk
Edna M. Kirk
(Signature of Registrant)

Subscribed and sworn to before me this 11th day of May, 1956

My commission expires 9-5-59 May
(Notary Public)

(SEAL)

CERTIFICATE OF REGISTRATION

STATE OF OREGON } ss.
County of Marion

This is to certify that the foregoing Registration Statement was received in the office of the State Engineer on the 11th day of May, 1956 at 8 o'clock A.M. and has been duly recorded in said office in Book No. 1 of Registration Statements on page GR-170 C

~~Copy of this certificate shall be kept by the State Engineer and the original copy shall be kept by the applicant.~~

Witness my hand this 8th day of October, 1956
Lewis A. Stanley
(State Engineer)

By _____ (Deputy)