


North

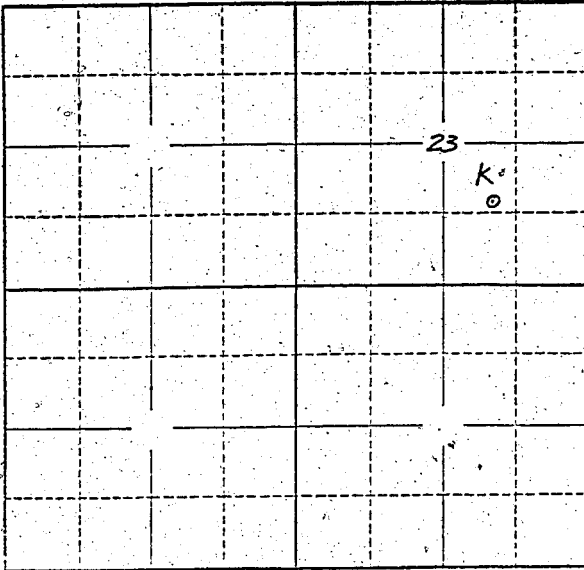

Locate well and acreage of irrigated land on plat.
Scale: 1/2" = 1 Mile

STATE OF OREGON

County of Marion } ss.

I, Melvin Stinnett, being first duly sworn, do hereby certify that I have read the foregoing Registration Statement and that all of the items therein contained are true to the best of my knowledge and belief.

Melvin Stinnett
(Signature of Registrant)

Subscribed and sworn to before me this 30th day of June, 1958

My commission expires 12th June 1961 Wm. S. Bartholomew
(Notary Public)

(SEAL)

CERTIFICATE OF REGISTRATION

STATE OF OREGON } ss.
County of Marion

This is to certify that the foregoing Registration Statement was received in the office of the State Engineer on the 30th day of June, 1958, at 3:00 o'clock P. M. and has been duly recorded in said office in Book No. 8 of Registration Statements on page GR 1785

~~Construction shall be completed by 12 and the water completely applied for beneficial use by 12~~

Witness my hand this 7th day of January, 1959

Laura A. Stanley
(State Engineer)

\$15.00

By _____ (Deputy)

GR-1785