


North

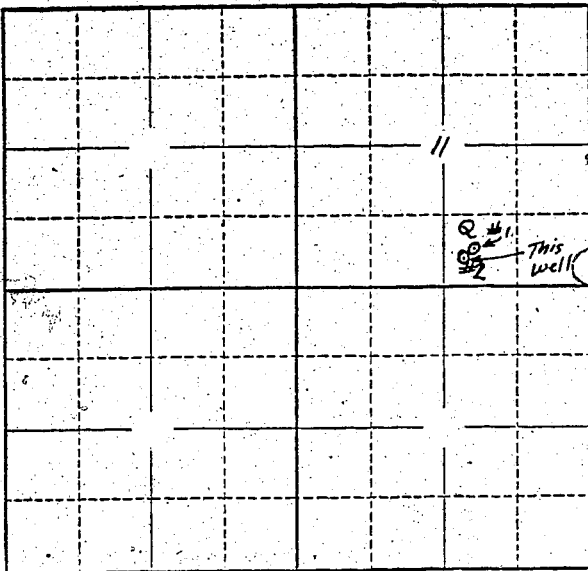

Locate well and acreage of irrigated land on plat.

Scale: 2" = 1 Mile

STATE OF OREGON

County of LINN } ss.

I, John E. and Katie M. Grenz & George V. Grenz, being first duly sworn, do hereby certify that I have read the foregoing Registration Statement and that all of the items therein contained are true to the best of my knowledge and belief.

John E. Grenz Katie M. Grenz
(Signature of Registrant)

Subscribed and sworn to before me this 25th day of June, 1959.

My commission expires _____
MY COMMISSION EXPIRES JULY 25, 1960

Wendy A. Shivers
(Notary Public)

(SEAL)

CERTIFICATE OF REGISTRATION

STATE OF OREGON } ss.
County of Marion

This is to certify that the foregoing Registration Statement was received in the office of the State Engineer on the 30th day of June, 1959, at 8:00 o'clock A. M. and has been duly recorded in said office in Book No. 8 of Registration Statements on page GR-1801

Witness my hand this 26th day of January, 1959

Lewis A. Stanley
(State Engineer)

By _____
(Deputy)

\$15.00