


North

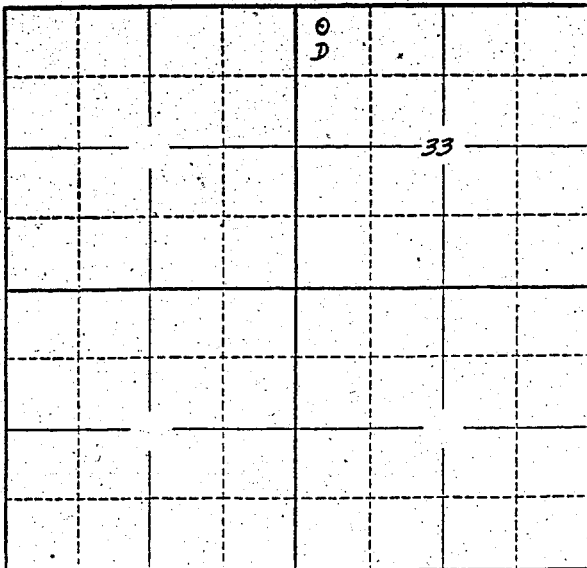

Locate well and acreage of irrigated land on plat:

Scale: 2" - 1 Mile

STATE OF OREGON

County of LINN } ss.

I, George C. and Mary M. Metcalf, being first duly sworn, do hereby certify that I have read the foregoing Registration Statement and that all of the items therein contained are true to the best of my knowledge and belief.

George C Metcalf

Mary M Metcalf  
(Signature of Registrant)

Subscribed and sworn to before me this 27 day of June, 1958

My commission expires .....

Asks  
(Notary Public)

(SEAL)

**CERTIFICATE OF REGISTRATION**

STATE OF OREGON } ss.  
County of Marion

This is to certify that the foregoing Registration Statement was received in the office of the State Engineer on the 30<sup>th</sup> day of June, 1958, at 8:00 o'clock A.M. and has been duly recorded in said office in Book No. 8 of Registration Statements on page GR-1803

Witness my hand this 26<sup>th</sup> day of January

19 59  
Lewis A. Stanley  
(State Engineer)

By .....  
(Deputy)

\$15.00