


North

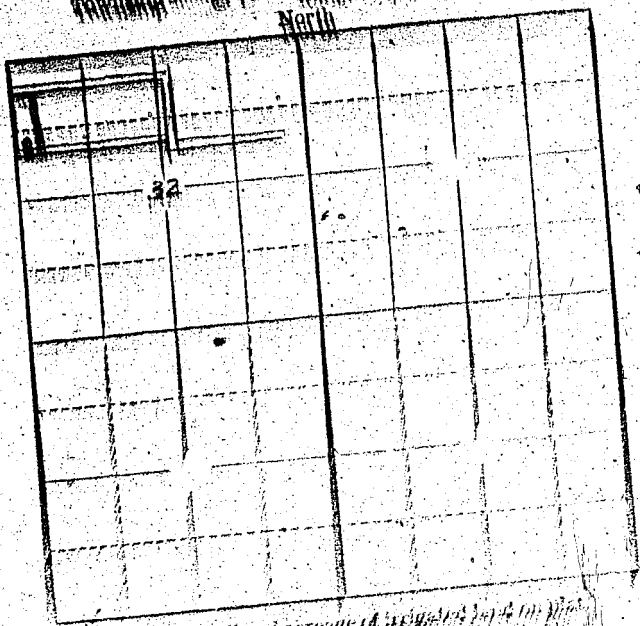

... ..
Scale: 1/100

STATE OF ...
COUNTY OF ...

Maria

... ..
... ..

W. J. ...

...

... ..
... ..

...

...

...

...

... ..
... ..

... ..
... ..

... ..
... ..