


Township 8 S Range 4 W, W.M.
North

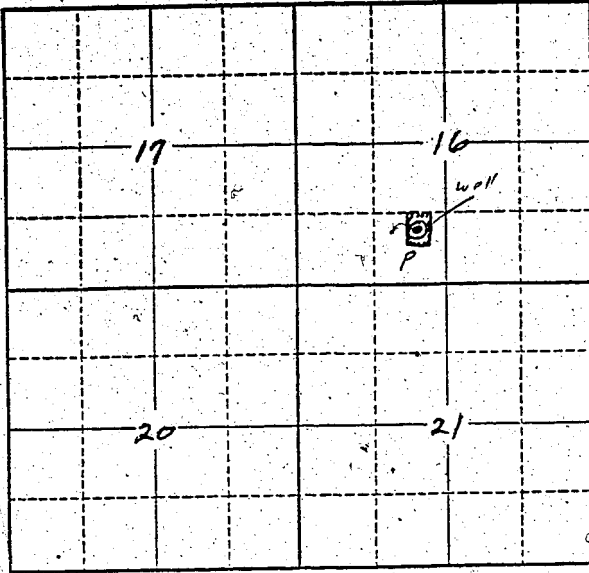

Locate well and acreage of irrigated land on plat.
Scale: 2" = 1 Mile

STATE OF OREGON }
County of PAK } ss.

I, Russell Guy SANDERLIN, being first duly sworn, do hereby certify that I have read the foregoing Registration Statement and that all of the items therein contained are true to the best of my knowledge and belief.

Russell Guy Sanderlin
(Signature of Registrant)

Subscribed and sworn to before me this 30 day of JUNE, 1958.

My commission expires August 21, 1960
Russell G. Sanderlin
(Notary Public)

(SEAL)

CERTIFICATE OF REGISTRATION

STATE OF OREGON }
County of Marion } ss.

This is to certify that the foregoing Registration Statement was received in the office of the State Engineer on the 1st day of July, 1958, at 8:00 o'clock A.M. and has been duly recorded in said office in Book No. 8 of Registration Statements on page GR-1815

Witness my hand this 26th day of January, 1959.
Lewis A. Steadley
(State Engineer)

By _____
(Deputy)

\$1,500

GR-1815