Township 6N Range 35E, W.M.

North

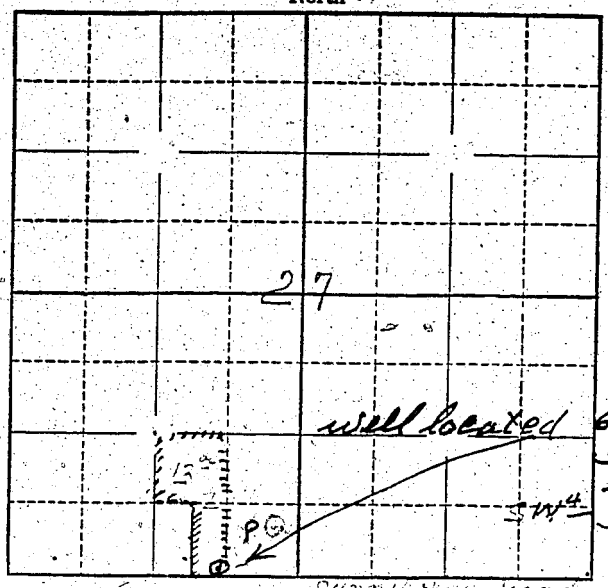

Locate well and acreage of irrigated land on plat.

Scale: ~~2"~~ = 1 Mile
4" = 1"

STATE OF OREGON
County of [illegible] } ss.

I, Wilbur Blaine, being first duly sworn, do hereby certify that I have read the foregoing Registration Statement and that all of the items therein contained are true to the best of my knowledge and belief.

Wilbur E. Blaine
(Signature of Registrant)

Subscribed and sworn to before me this [illegible] day of [illegible], 19[illegible].

My commission expires [illegible]

(Notary Public)

(SEAL)

CERTIFICATE OF REGISTRATION

STATE OF OREGON
County of Marion } ss.

This is to certify that the foregoing Registration Statement was received in the office of the State Engineer on the 2nd day of July, 1958, at 8:00 o'clock A M. and has been duly recorded in said office in Book No. 8 of Registration Statements on page GR-1822

Witness my hand this 26th day of January, 1959.

Lewis A. Stanley
(State Engineer)

$15.00

By [illegible]
(Deputy)

GR-1822