


North

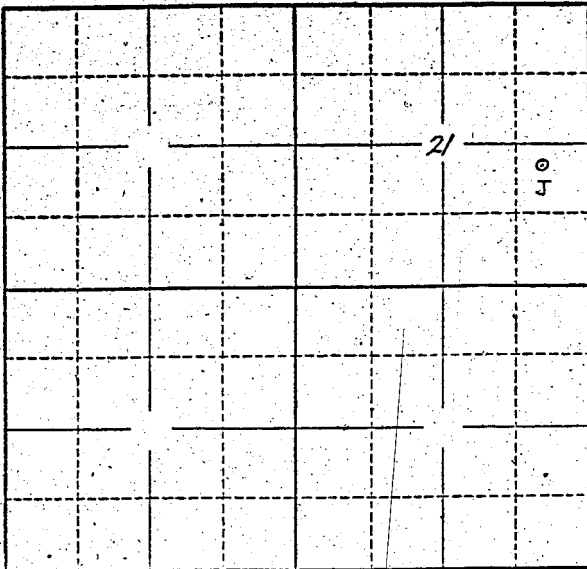

Locate well and acreage of irrigated land on plat.

Scale: 2" = 1 Mile

STATE OF OREGON

County of LINN

} ss.

I, Harold and Dorothea Lines, being first duly sworn, do hereby certify that I have read the foregoing Registration Statement and that all of the items therein contained are true to the best of my knowledge and belief.

Harold Lines

(Signature of Registrant)

Subscribed and sworn to before me this 30 day of June, 1958

My commission expires July 22 - 1959

[Signature]

(Notary Public)

(SEAL)

CERTIFICATE OF REGISTRATION

STATE OF OREGON

County of Marion

} ss.

This is to certify that the foregoing Registration Statement was received in the office of the State Engineer on the 2nd day of July, 1958, at 8:00 o'clock A.M. and has been duly recorded in said office in Book No. 8 of Registration Statements on page GR-1824


Witness my hand this 26th day of January, 1959

Laura A. Stanley

(State Engineer)

By _____
(Deputy)

#1650

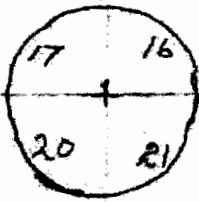

2P-69
Linn Co.
21 22


To ALBANY



Howell & Brotha Lines
Rte 2 Box 226
Lebanon

SECTIONS 21+22, T. 11S., R. 2W.

GR-1886

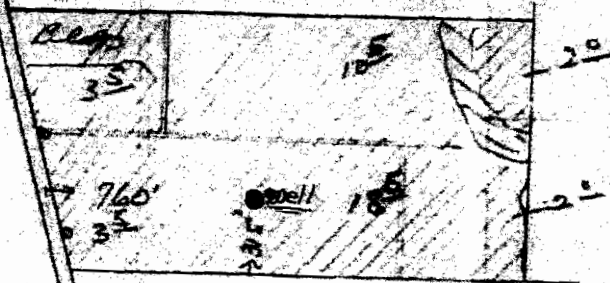

STATE ENGINEER
SALEM OREGON