


Township 12S Range 5W, W.M.
North

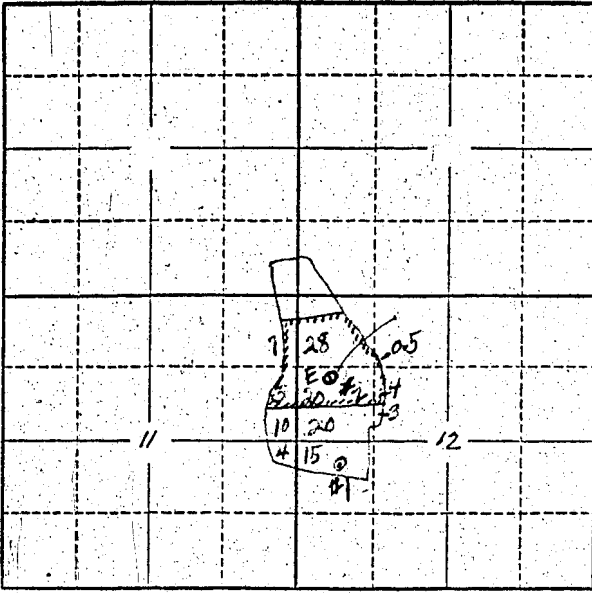

Locate well and acreage of irrigated land on plat.
Scale: 2" = 1 Mile

STATE OF OREGON

County of Marion } ss.

I, Oscar Hernandez, being first duly sworn, do hereby certify that I have read the foregoing Registration Statement and that all of the items therein contained are true to the best of my knowledge and belief.

Oscar Hernandez
(Signature of Registrant)

Subscribed and sworn to before me this 30th day of June, 1958

My commission expires Feb. 14, 1961 E. H. Bailey
(Notary/Public)

(SEAL)

CERTIFICATE OF REGISTRATION

STATE OF OREGON } ss.
County of Marion

This is to certify that the foregoing Registration Statement was received in the office of the State Engineer on the 2nd day of July, 1958, at 8:00 o'clock A. M. and has been duly recorded in said office in Book No. 12 of Registration Statements on page GR 2748

Witness my hand this 25th day of May, 1959

W. A. Stanley
(State Engineer)

By _____
(Deputy)

\$ 20.25