


Township T3S, Range R2W, W.M. North

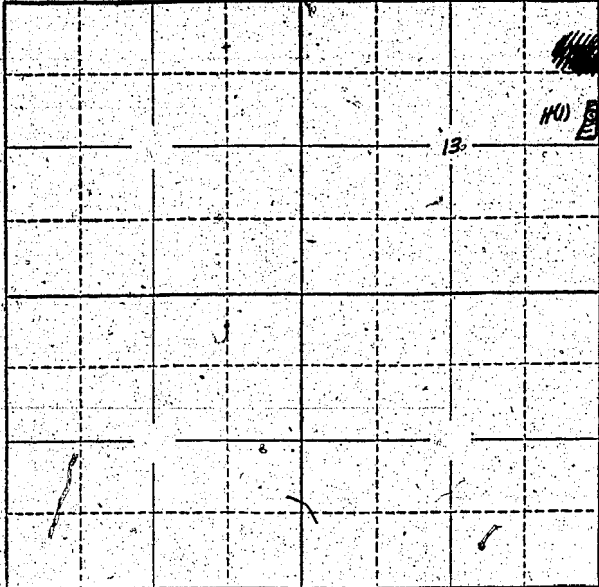

Map in file GR-189

Locate well and acreage of irrigated land on plat.  
Scale: 2" = 1 Mile

STATE OF OREGON }  
County of Marion } ss.

I, Kilian W. Smith, being first duly sworn, do hereby certify that I have read the foregoing Registration Statement and that all of the items therein contained are true to the best of my knowledge and belief.

Kilian W. Smith  
(Signature of Registrant)

Subscribed and sworn to before me this 22<sup>nd</sup> day of May, 1956

My commission expires Sept. 8, 1956

Ch. J. Blum  
(Notary Public)

(SEAL)

**CERTIFICATE OF REGISTRATION**

STATE OF OREGON }  
County of Marion } ss.

This is to certify that the foregoing Registration Statement was received in the office of the State Engineer on the 22nd day of May, 1956, at 1 o'clock P.M. and has been duly recorded in said office in Book No. 1 of Registration Statements on page GR-175 C

~~Registration shall be completed by \_\_\_\_\_ and the same accepted by \_\_\_\_\_~~

Witness my hand this 8th day of October, 1956

Lewis A. Stanley  
(State Engineer)

By \_\_\_\_\_  
(Deputy)

GR-175C