


Township 1N Range 3E, W.M.

North

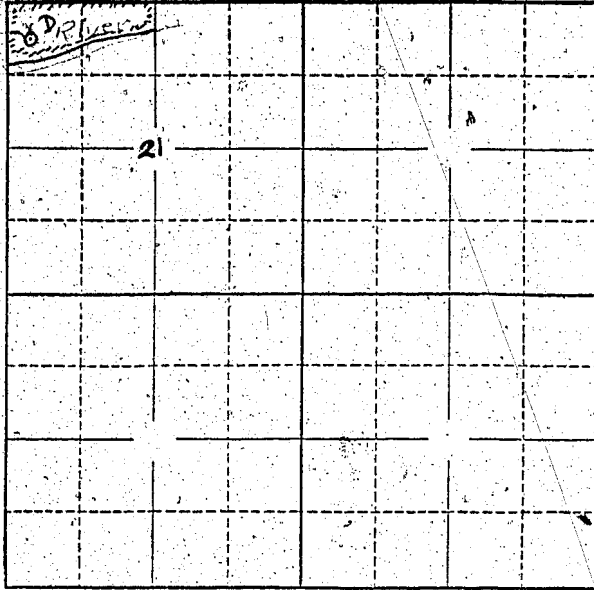

Locate well and acreage of irrigated land on plat.

Scale: 2" = 1 Mile

STATE OF OREGON

County of Malheur } ss.

I, Frank McROBERTS, being first duly sworn, do hereby certify that I have read the foregoing Registration Statement and that all of the items therein contained are true to the best of my knowledge and belief.

Frank McRoberts
(Signature of Registrant)

Subscribed and sworn to before me this 17th day of June, 1959.

My commission expires March 19-60 Geo. H. Hester
(Notary Public)

(SEAL)

CERTIFICATE OF REGISTRATION

STATE OF OREGON

County of Marion } ss.

This is to certify that the foregoing Registration Statement was received in the office of the State Engineer on the 20th day of June, 1959, at 1:00 o'clock P.M. and has been duly recorded in said office in-Book No. 16 of Registration Statements on page 3803.

Witness my hand this 4th day of December, 1959

Laura A. Stanley
(State Engineer)

By _____ (Deputy)

\$1,500