


Township 1N Range 1E W.M.  
North

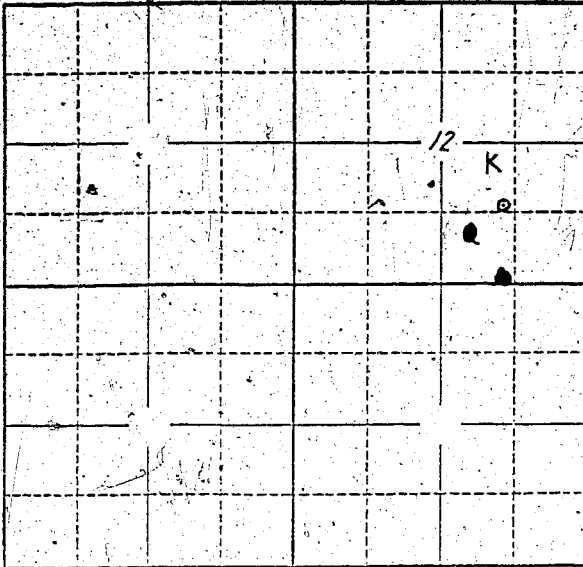

Locate well and acreage of irrigated land on plat.  
Scale: 2" = 1 Mile

STATE OF OREGON

County of Marion

ss.

I, Alice Huston, being first duly sworn, do hereby certify that I have read the foregoing Registration Statement and that all of the items therein contained are true to the best of my knowledge and belief.

Alice Huston  
(Signature of Registrant)

Subscribed and sworn to before me this 2nd day of July, 1958

My commission expires 12th June 1961

Wm. S. Bartholomew  
(Notary Public)

(SEAL)

**CERTIFICATE OF REGISTRATION**

STATE OF OREGON

County of Marion

ss.

This is to certify that the foregoing Registration Statement was received in the office of the State Engineer on the 2nd day of July, 1958, at 11:00 o'clock A.M. and has been duly recorded in said office in Book No. 8 of Registration Statements on page GR-1828


Witness my hand this 26th day of January, 1959

Lewis J. Estabrook  
(State Engineer)

By

(Deputy)

GR-1828

\$ 27.00