


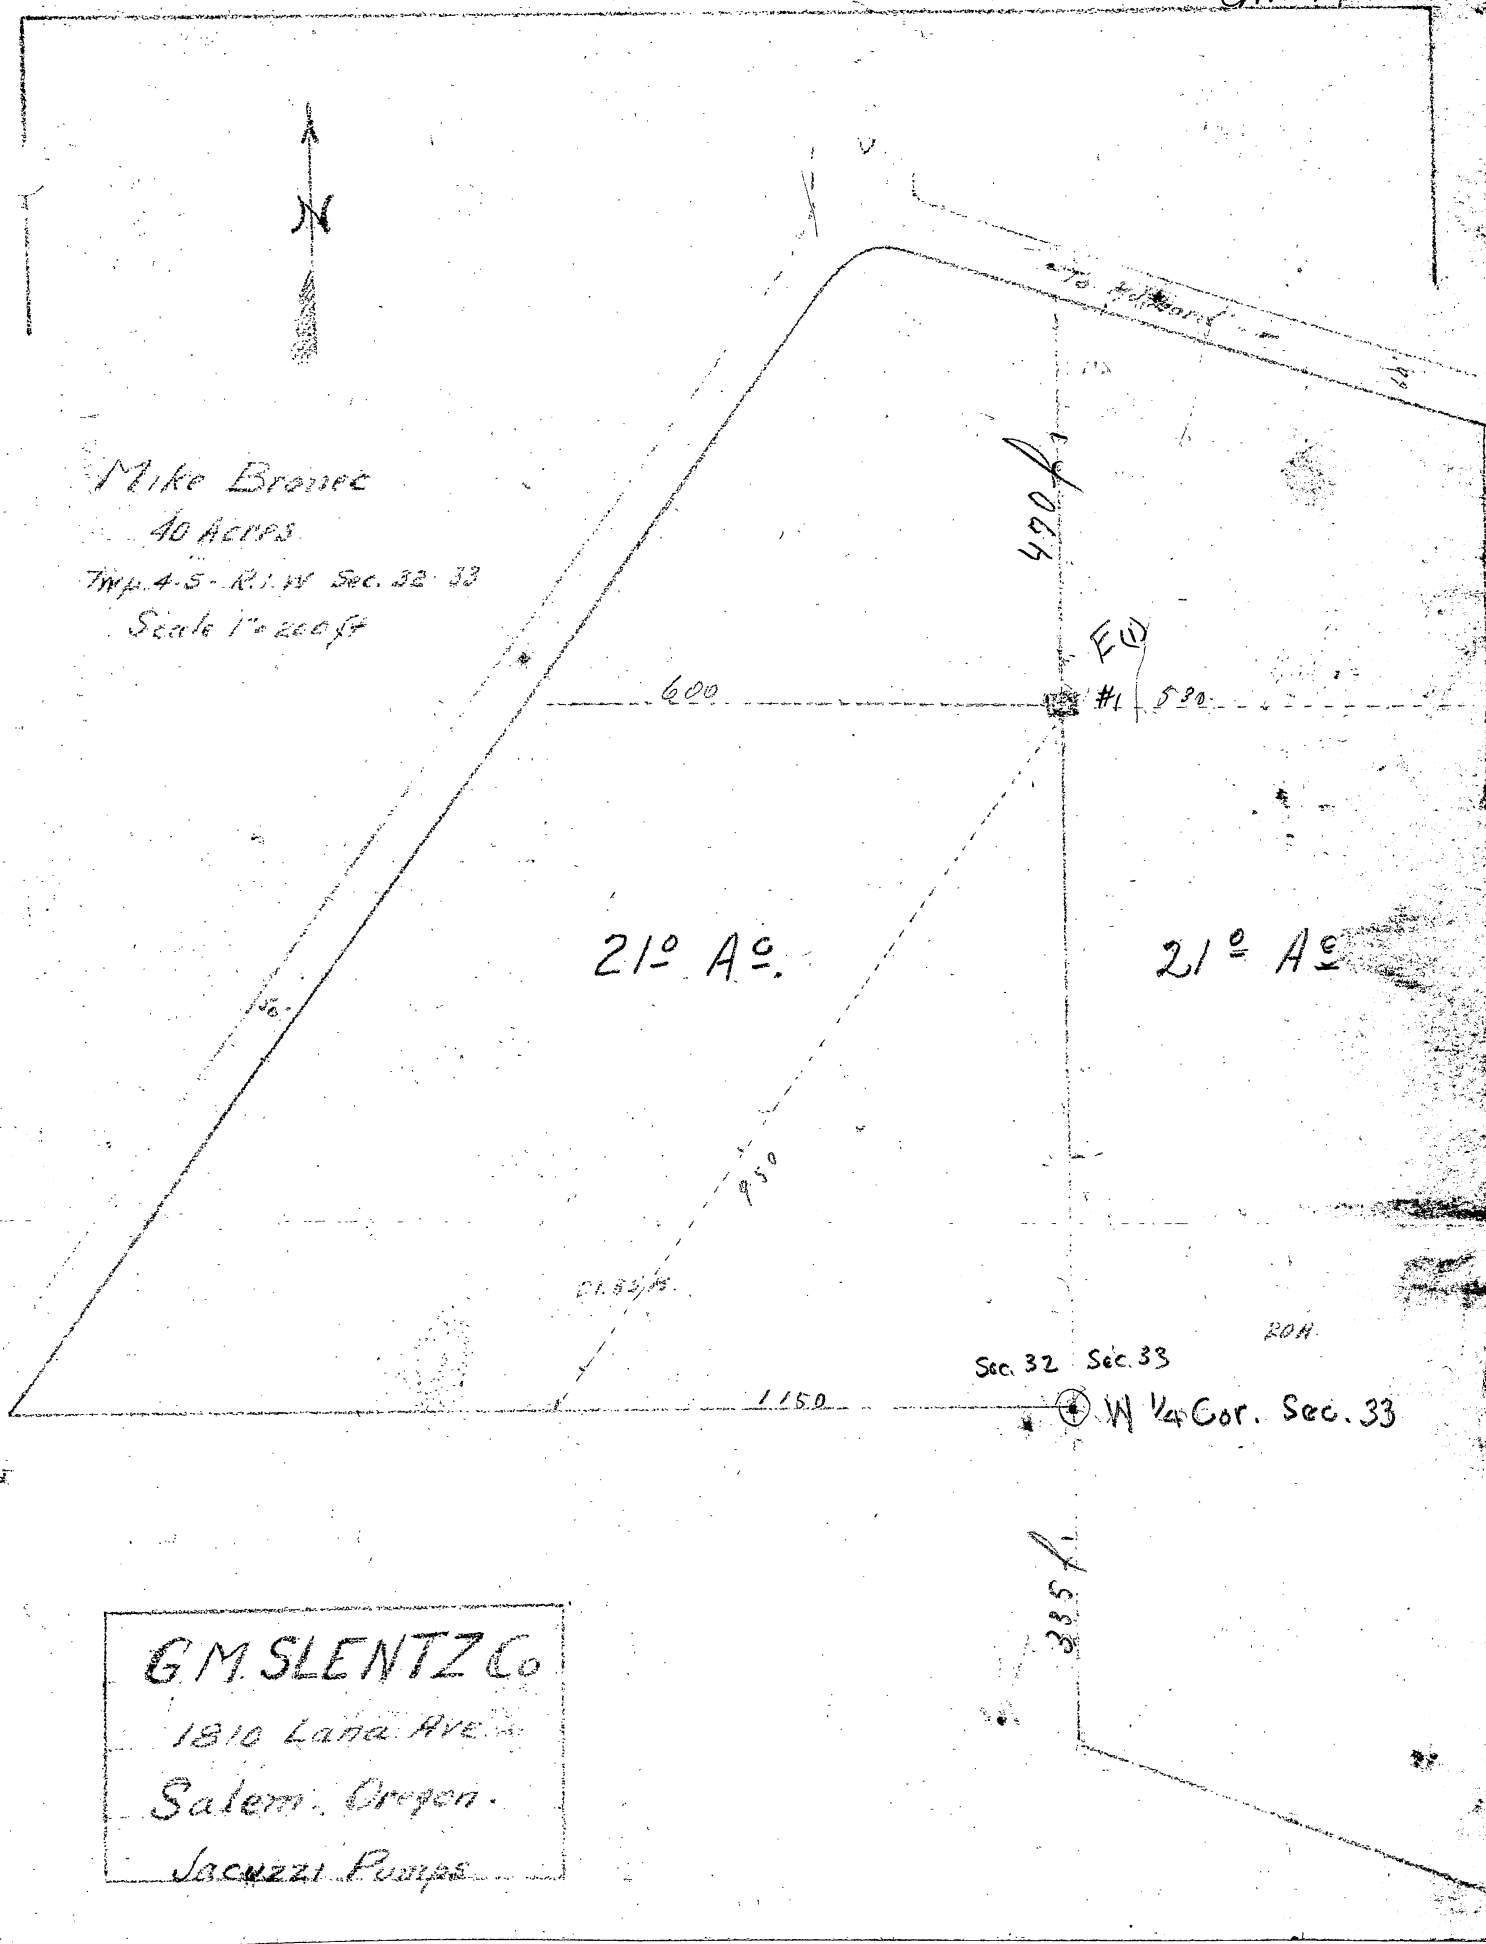

Mike Bronec  
40 Acres  
Twp. 4 S - R. 1 W Sec. 32 33  
Scale 1" = 200 ft



G.M. SLENTZ Co  
1810 Lana Ave.  
Salem, Oregon.  
Jacuzzi Pumps