


North

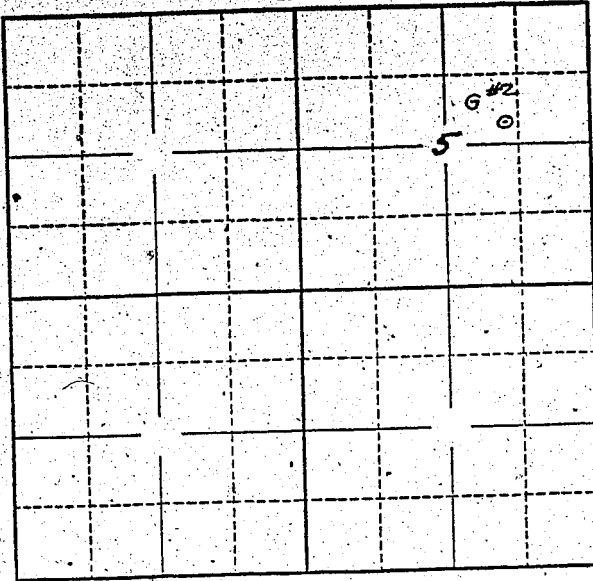

Locate well and acreage of irrigated land on plat.

Scale: 2" = 1 Mile

STATE OF OREGON

County of LIMON, ss.

I, Jack Pesheck, being first duly sworn, do hereby certify that I have read the foregoing Registration Statement and that all of the items therein contained are true to the best of my knowledge and belief.

Jack Pesheck (Signature of Registrant)

Subscribed and sworn to before me this 2nd day of July, 1958

My commission expires 8/19/59 Howard Carpenter (Notary Public)

(SEAL)

CERTIFICATE OF REGISTRATION

STATE OF OREGON ss. County of Marion

This is to certify that the foregoing Registration Statement was received in the office of the State Engineer on the 3rd day of July, 1958, at 8:00 o'clock A.M. and has been duly recorded in said office in Book No. 8 of Registration Statements on page GR-1837

Witness my hand this 26th day of January

1959 Lewis A. Stanley (State Engineer)

By (Deputy)

\$15.00