Township 15 Range 2E W.M.

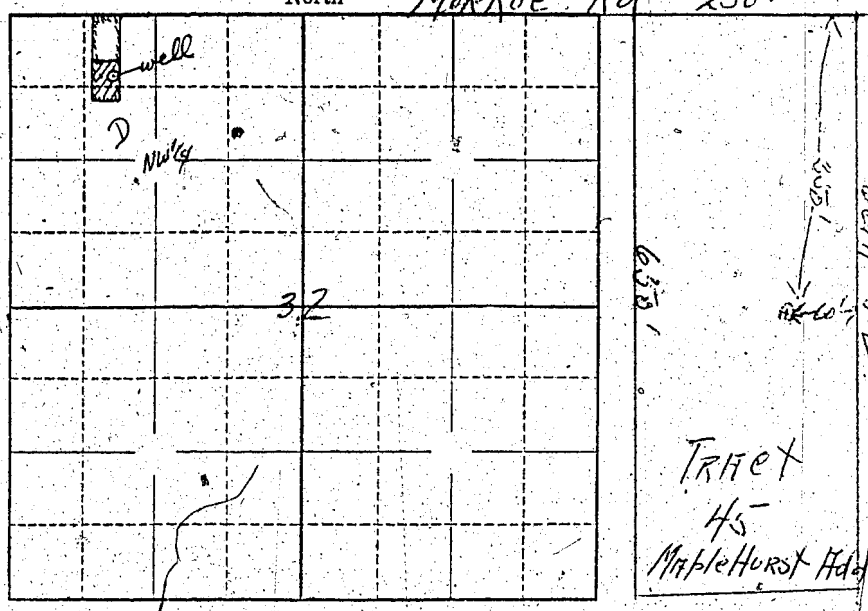

Locate well and acreage of irrigated land on plat.

Scale: 4" = 1 Mile

STATE OF OREGON
County of ..... } ss.

I, ..., being first duly sworn, do hereby certify that I have read the foregoing Registration Statement and that all of the items therein contained are true to the best of my knowledge and belief.

..... (Signature of Registrant)

Subscribed and sworn to before me this 1 day of July, 19 59.

My commission expires July 11, 1961 ..... (Notary Public)

(SEAL)

CERTIFICATE OF REGISTRATION

STATE OF OREGON
County of Marion } ss.

This is to certify that the foregoing Registration Statement was received in the office of the State Engineer on the 3rd day of July, 1959, at 1:00 o'clock P.M. and has been duly recorded in said office in Book No. 16 of Registration Statements on page GR-3805

Witness my hand this 4th day of December, 19 59

..... (State Engineer)

$15.00

By ..... (Deputy)

GR-3805