


Township T9S Range R4W W.M.
North

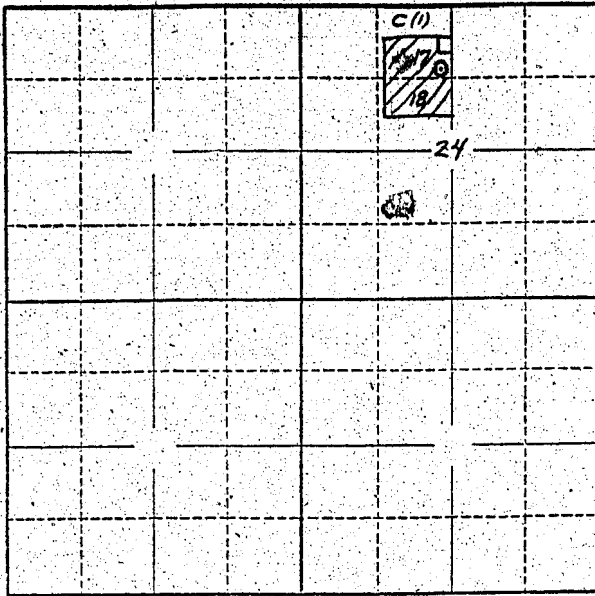

Locate well and acreage of irrigated land on plat.
Scale: 2" = 1 Mile

STATE OF OREGON

County of Marion } ss.

I, Wm Wiederkehr, being first duly sworn, do hereby certify that I have read the foregoing Registration Statement and that all of the items therein contained are true to the best of my knowledge and belief.

Wm Wiederkehr
(Signature of Registrant)

Subscribed and sworn to before me this 28th day of May, 1956.

My commission expires Sept 8, 1956 Chris T. Miller
(Notary Public)

(SEAL)

CERTIFICATE OF REGISTRATION

STATE OF OREGON } ss.
County of Marion

This is to certify that the foregoing Registration Statement was received in the office of the State Engineer on the 28th day of May, 1956, at 10:30 clock A. M. and has been duly recorded in said office in Book No. 1 of Registration Statements on page GE-177 C

~~Construction shall be completed by _____ and the water completely applied to beneficial use by _____~~

Witness my hand this 8th day of October

Leura A. Stanley 1956
(State Engineer)

By _____
(Deputy)

GR-177 C