


Township 6S Range 3W W.M.  
North

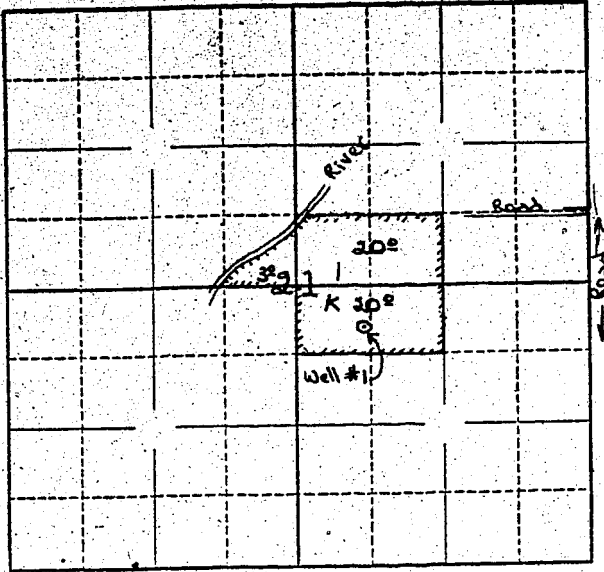

Locate well and acreage of irrigated land on plat.  
Scale: 2" = 1 Mile

STATE OF OREGON }  
County of Marion } ss.

I, Martha Jane Pearcy, being first duly sworn, do hereby certify that I have read the foregoing Registration Statement and that all of the items therein contained are true to the best of my knowledge and belief.

Martha Jane Pearcy  
(Signature of Registrant)

Subscribed and sworn to before me this 2d day of July, 1958

My commission expires Oct. 16, 1959 Wesley H. Johnson  
(Notary Public)

(SEAL)

**CERTIFICATE OF REGISTRATION**

STATE OF OREGON }  
County of Marion } ss.

This is to certify that the foregoing Registration Statement was received in the office of the State Engineer on the 7th day of July, 1958, at 11:00 o'clock A. M. and has been duly recorded in said office in Book No. 8 of Registration Statements on page GR 1846

Witness my hand this 26th day of January, 1959.  
Henry A. Stanley  
(State Engineer)

By \_\_\_\_\_ (Deputy)

1/16/59