


Township 6S Range 3W, W.M.
North

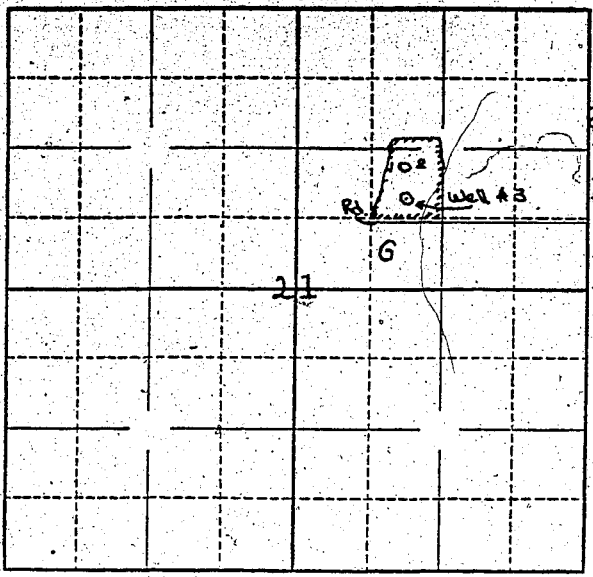

Locate well and acreage of irrigated land on plat.
Scale: 2" = 1 Mile

STATE OF OREGON }
County of Marion } ss.

I, Martha Jane Percy, being first duly sworn, do hereby certify that I have read the foregoing Registration Statement and that all of the items therein contained are true to the best of my knowledge and belief.

Martha Jane Percy
(Signature of Registrant)

Subscribed and sworn to before me this 2d day of July, 1958

My commission expires Oct. 16, 1959

Maeda H. Johnson
(Notary Public)

(SEAL)

CERTIFICATE OF REGISTRATION

STATE OF OREGON }
County of Marion } ss.

This is to certify that the foregoing Registration Statement was received in the office of the State Engineer on the 2th day of July, 1958, at 11⁰⁰ o'clock A M. and has been duly recorded in said office in Book No. 8 of Registration Statements on page GR-1848

Witness my hand this 26th day of January, 1959

Laura A. Stanley
(State Engineer)

\$15.00

By _____ (Deputy)