


Township 2 So Range 9 W W.M.
North

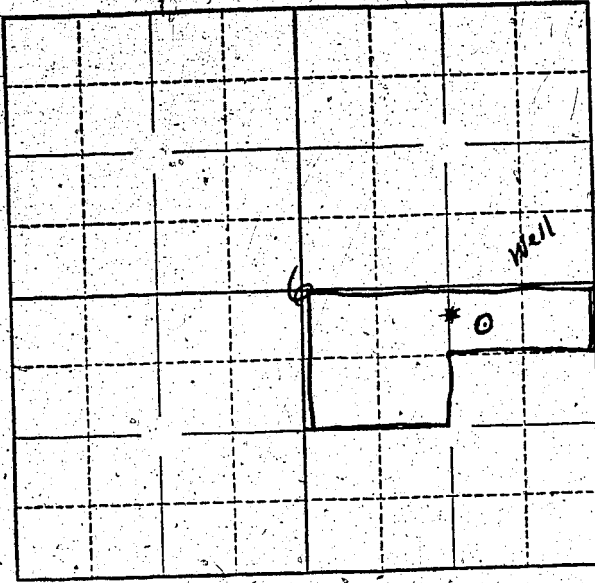

Locate well and acreage of irrigated land on plat.

Scale: 1/4 - 1 Mile

STATE OF OREGON

County of Umatilla } ss.

I, Harry Elliott, being first duly sworn, do hereby certify that I have read the foregoing Registration Statement and that all of the items therein contained are true to the best of my knowledge and belief.

Harry Elliott
(Signature of Registrant)

Subscribed and sworn to before me this 26 day of July, 1958.

My commission expires 9/10/58
J. P. Peterson
(Notary Public)

(SEAL)

CERTIFICATE OF REGISTRATION

STATE OF OREGON } ss.
County of Marion

This is to certify that the foregoing Registration Statement was received in the office of the State Engineer on the 7th day of July, 1958, at 8:00 o'clock A. M. and has been duly recorded in said office in Book No. 9 of Registration Statements on page GR-1903.

Witness my hand this 9th day of February, 1959
Henry A. Stanley
(State Engineer)

\$ 19.50

By _____ (Deputy)

GR-1903