


North

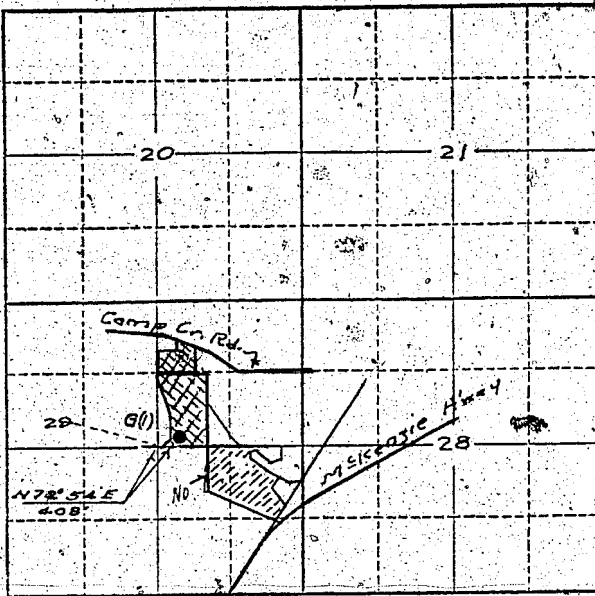

Locate well and acreage of irrigated land on plat:

Scale: 2" = 1 Mile

STATE OF OREGON

County of Rowe

ss.

I, Glen Vaughn, being first duly sworn, do hereby certify that I have read the foregoing Registration Statement and that all of the items therein contained are true to the best of my knowledge and belief.

Glen Vaughn
(Signature of Registrant)

Subscribed and sworn to before me this 31 day of May, 1956

NOTARY PUBLIC FOR OREGON

My commission expires Feb. 7, 1961

[Signature]
(Notary Public)

(SEAL)

CERTIFICATE OF REGISTRATION

STATE OF OREGON

County of Marion

ss.

This is to certify that the foregoing Registration Statement was received in the office of the State Engineer on the 31st day of May, 1956, at 9 o'clock A.M. and has been duly recorded in said office in Book No. 1 of Registration Statements on page GR-178 G

Witness my hand this 8th day of October, 1956

[Signature]
(State Engineer)

By _____ (Deputy)

GR-178 G