


Township 17S Range 3W, W.M.
North

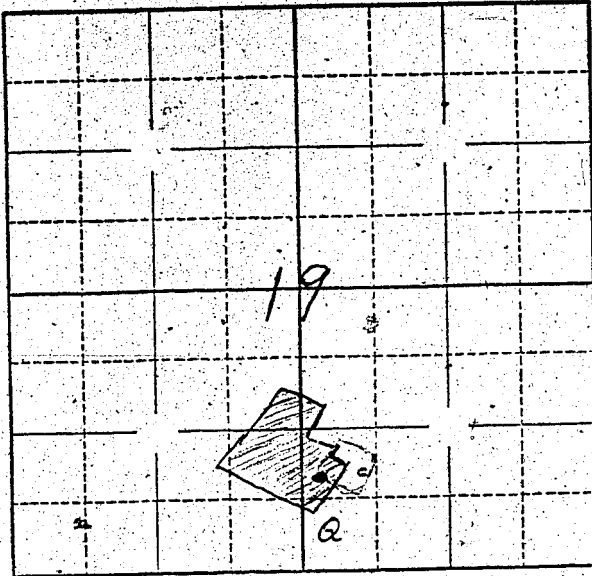

Locate well and acreage of irrigated land on plat.
Scale: 2" = 1 Mile

STATE OF OREGON

County of Lane } ss.

I, J. Francis Whitney, being first duly sworn, do hereby certify that I have read the foregoing Registration Statement and that all of the items therein contained are true to the best of my knowledge and belief.

J. Francis Whitney
(Signature of Registrant)

Subscribed and sworn to before me this 3rd day of July, 1958.

My commission expires Aug. 17, 1958

Daniel F. Robinson
(Notary Public)

(SEAL)

CERTIFICATE OF REGISTRATION

STATE OF OREGON }
County of Marion } ss.

This is to certify that the foregoing Registration Statement was received in the office of the State Engineer on the 7th day of July, 1958, at 8:00 o'clock A.M. and has been duly recorded in said office in Book No. 8 of Registration Statements on page GR-1854

Witness my hand this 26th day of January, 1959.

Lewis A. Stanley
(State Engineer)

By _____ (Deputy)

GR - 1854

\$1500