Township 11 S Range 2 W W.M.

North

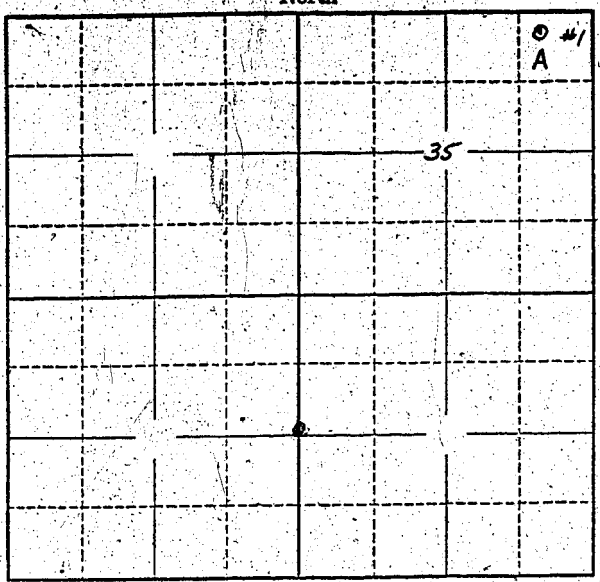


Locate well and acreage of irrigated land on plat.

Scale: 2" — 1 Mile

STATE OF OREGON
County of Linn } ss.

I, Sylva Carter, being first duly sworn, do hereby certify that I have read the foregoing Registration Statement and that all of the items therein contained are true to the best of my knowledge and belief.

Sylva Carter
(Signature of Registrant)

Subscribed and sworn to before me this 1st day of July, 1958

Gayle McVey
(Notary Public)

My commission expires MY COMMISSION EXPIRES MARCH 12, 1959

(SEAL)

[redacted]ATE OF REGISTRATION

STATE OF OREGON
County of Marion } ss.

This is to certify that the foregoing Registration Statement was received in the office of the State Engineer on the 7th day of July, 19 58, at 8:00 o'clock A M. and has been duly recorded in said office in Book No. 8 of Registration Statements on page GR-1855

Witness my hand this 26th day of January, 19 59

Lewis A. Stanley
(State Engineer)

By
(Deputy)

#15.00

GR-1855

# Groundwater Registration Modification - GR 1927

## Braun

*Township 11S, Range 2W, W.M.*

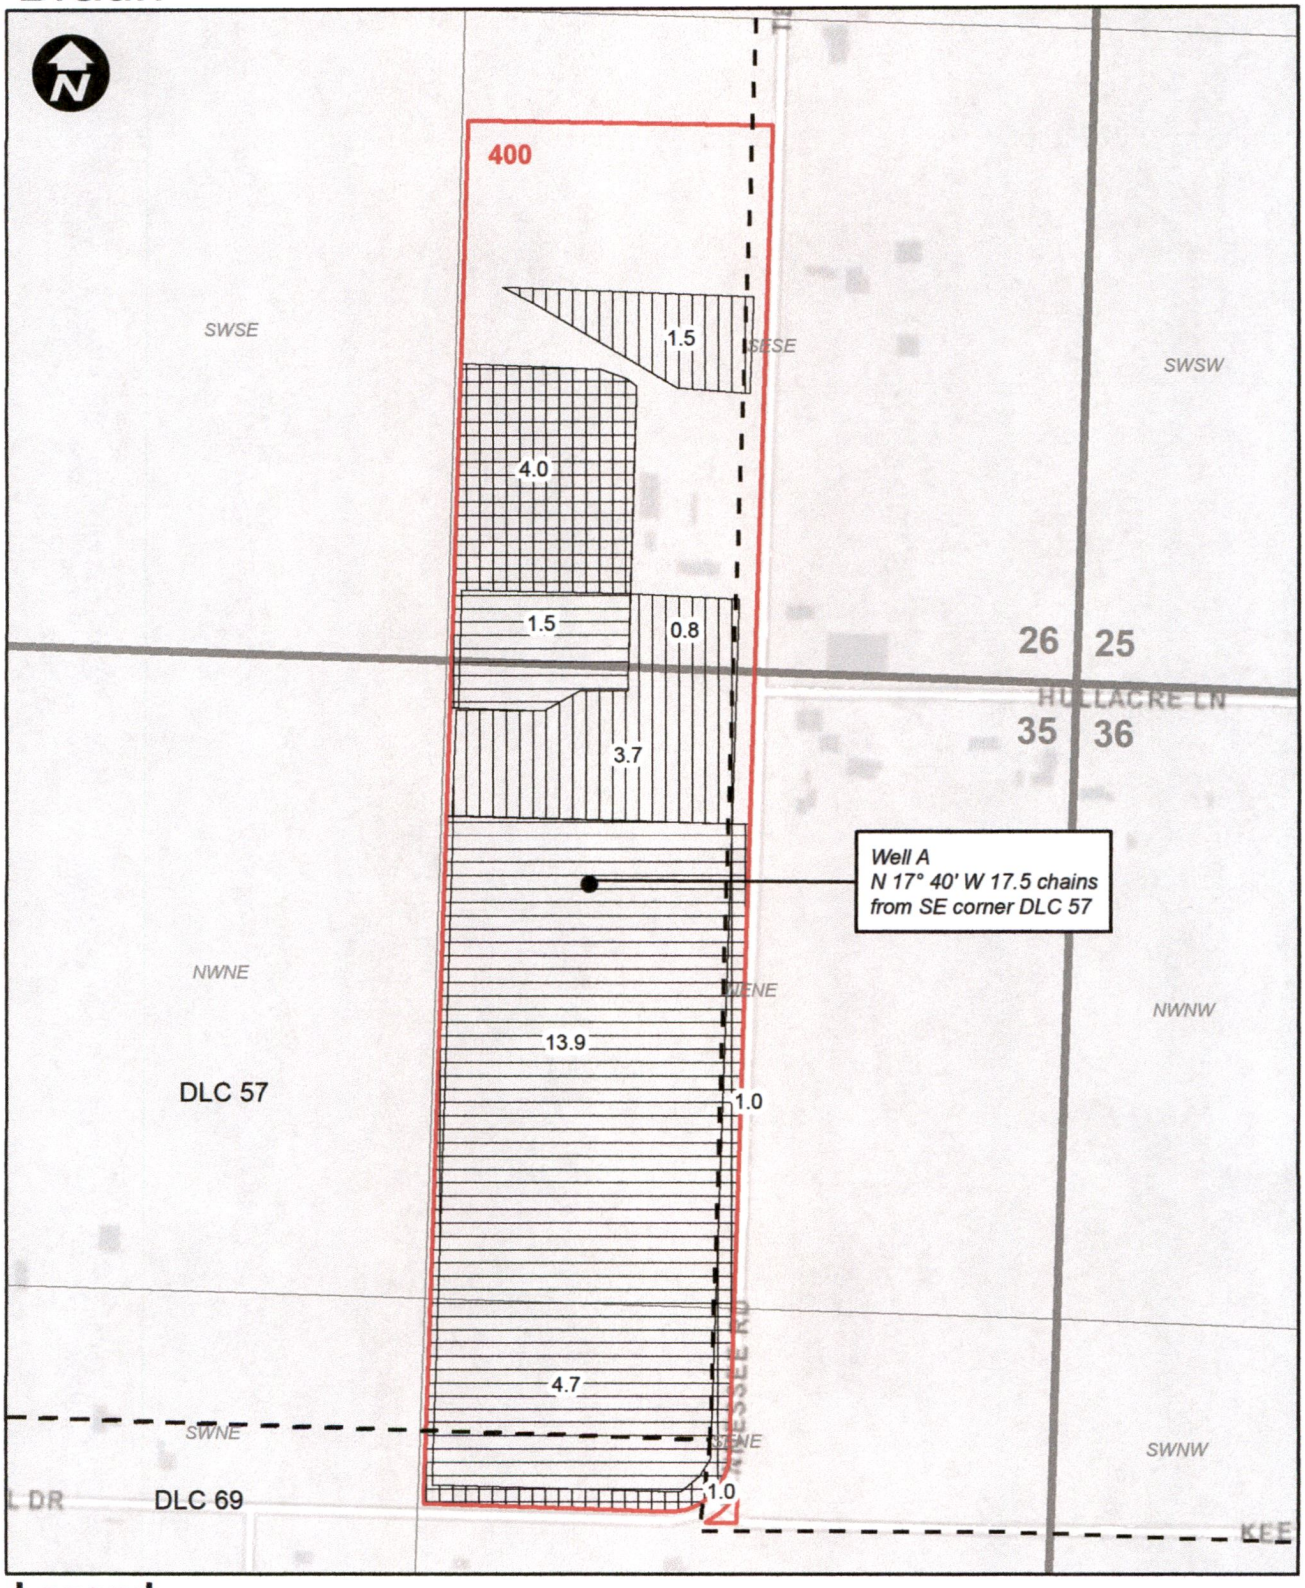


**Legend**

GR 1927 From | GR 1927 No Change | DLC

GR 1927 To | Taxlot

0 200 400 800 Feet

RECEIVED

MAY 19 2023

OWRD

WILL MCGILL SURVEYING LLC

14249 -