


North

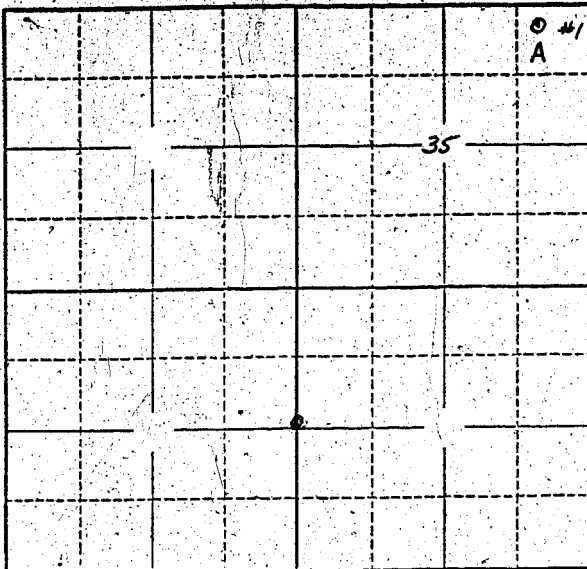

Locate well and acreage of irrigated land on plat.

Scale: 2" = 1 Mile

STATE OF OREGON

County of Linn

ss.

I, Sylva Carter, being first duly sworn, do hereby certify that I have read the foregoing Registration Statement and that all of the items therein contained are true to the best of my knowledge and belief.

Sylva Carter (Signature of Registrant)

Subscribed and sworn to before me this 1st day of July, 1957

My commission expires COMMISSION EXPIRES MARCH 12, 1959

(Notary Public)

(SEAL)

STATE OF REGISTRATION

STATE OF OREGON

County of Marion

ss.

This is to certify that the foregoing Registration Statement was received in the office of the State Engineer on the 7th day of July, 1957, at 8:00 o'clock A.M. and has been duly recorded in said office in Book No. 8 of Registration Statements on page GR-1855

Witness my hand this 26th day of January, 1959

Lewis A. Stanley (State Engineer)

By

(Deputy)