


Township 6S Range 2W, W.M.

North 4

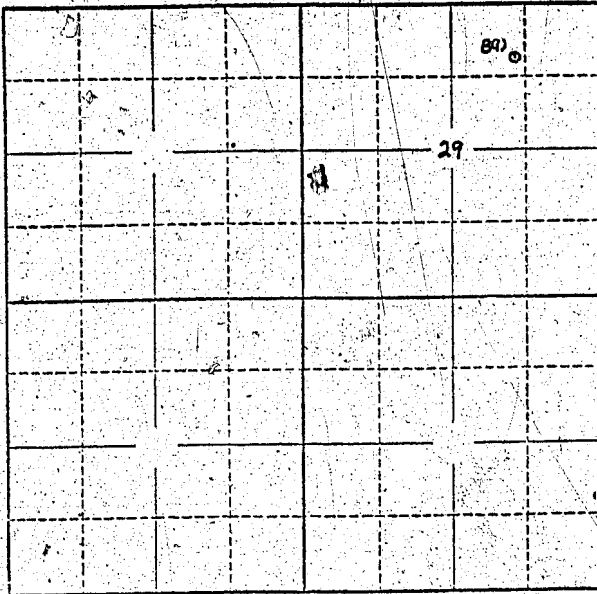

Locate well and acreage of irrigated land on plat.

Scale: 2" = 1 Mile

STATE OF OREGON

County of Marion

ss.

I, J. W. Fitts, being first duly sworn, do hereby certify that I have read the foregoing Registration Statement and that all of the items therein contained are true to the best of my knowledge and belief.

J. W. Fitts
(Signature of Registrant)

Subscribed and sworn to before me this 6 day of June, 1956.

My commission expires 9/27/58

Jeanie Baxter
(Notary Public)

(SEAL)

CERTIFICATE OF REGISTRATION

STATE OF OREGON

County of Marion

ss.

This is to certify that the foregoing Registration Statement was received in the office of the State Engineer on the 6th day of June, 1956, at 2:25 o'clock P. M. and has been duly recorded in said office in Book No. 1 of Registration Statements on page GR-179 S.

~~_____ and the water completely supplied to _____~~

Witness my hand this 8th day of October, 1956

Lewis A. Stanley
(State Engineer)

By _____ (Deputy)

GR-179 S