


Township 55 Range 3W W.M.
North

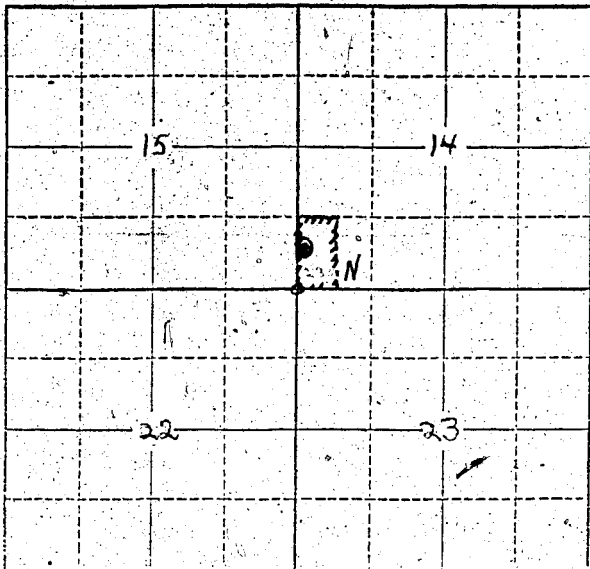

Locate well and acreage of irrigated land on plat.

Scale: 2" = 1 Mile

STATE OF OREGON

County of Marion } ss.

I, Albert Schendler, being first duly sworn, do hereby certify that I have read the foregoing Registration Statement and that all of the items therein contained are true to the best of my knowledge and belief.

Albert Schendler
(Signature of Registrant)

Subscribed and sworn to before me this 7th day of July, 1958.

My commission expires September 8, 1960
Max J. Jones
(Notary Public)

(SEAL)

CERTIFICATE OF REGISTRATION

STATE OF OREGON }
County of Marion } ss.

This is to certify that the foregoing Registration Statement was received in the office of the State Engineer on the 7th day of July, 1958, at 1:30 o'clock P. M. and has been duly recorded in said office in Book No. 8 of Registration Statements on page GR-1861

~~Construction of the canal to be completed by January 1, 1959, and the water completely applied to the land to be used by January 1, 1960.~~

Witness my hand this 26th day of January, 1959

Laura A. Stankus
(State Engineer)

\$15.00

By _____ (Deputy)

GR-1861