


Township 145 Range 4 W, W.M.  
North

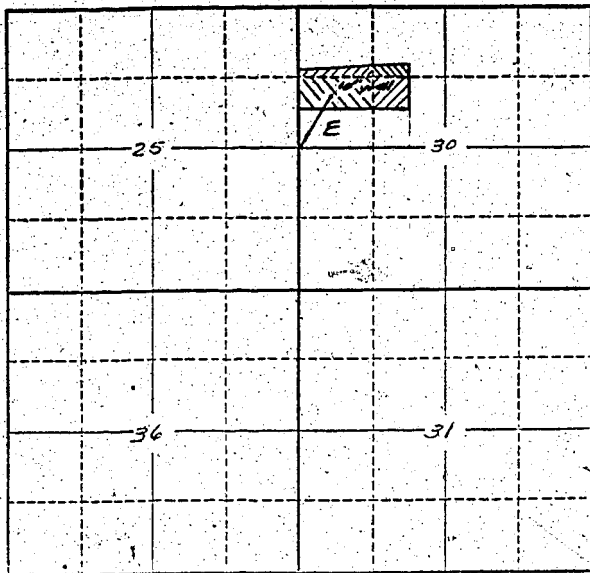

Locate well and acreage of irrigated land on plat.

Scale: 2" = 1 Mile

STATE OF OREGON

County of Marion } ss.

I, Victor Hallauer, being first duly sworn, do hereby certify that I have read the foregoing Registration Statement and that all of the items therein contained are true to the best of my knowledge and belief.

Victor Hallauer  
(Signature of Registrant)

Subscribed and sworn to before me this 7<sup>th</sup> day of July, 1958.

My commission expires Sept 8, 1960

Chas. E. ...  
(Notary Public)

(SEAL)

**CERTIFICATE OF REGISTRATION**

STATE OF OREGON }  
County of Marion } ss.

This is to certify that the foregoing Registration Statement was received in the office of the State Engineer on the 7<sup>th</sup> day of July, 1958, at 4<sup>00</sup> o'clock P.M. and has been duly recorded in said office in Book No. 8 of Registration Statements on page GR-1867.

Witness my hand this 26<sup>th</sup> day of January, 1959.

Laura A. ...  
(State Engineer)

By \_\_\_\_\_ (Deputy)

#16.80

GR-1867