


North

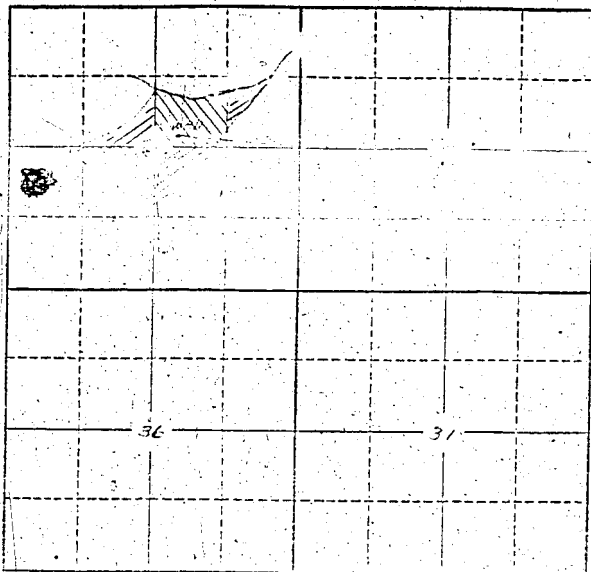

Locate well and acreage of irrigated land on plat.

Scale: 2" = 1 Mile

STATE OF OREGON

County of Marion } ss.

I, Victor Hallner, being first duly sworn, do hereby certify that I have read the foregoing Registration Statement and that all of the items therein contained are true to the best of my knowledge and belief.

Victor Hallner  
(Signature of Registrant)

Subscribed and sworn to before me this 7<sup>th</sup> day of July, 1958.

My commission expires Sept. 8, 1960  
Chas. L. Wheeler  
(Notary Public)

(SEAL)

**CERTIFICATE OF REGISTRATION**

STATE OF OREGON }  
County of Marion } ss.

This is to certify that the foregoing Registration Statement was received in the office of the State Engineer on the 7<sup>th</sup> day of July, 1958, at 400 o'clock P. M. and has been duly recorded in said office in Book No. 8 of Registration Statements on page GR-1811

~~Construction shall be completed by \_\_\_\_\_ and the water completely applied to \_\_\_\_\_~~

Witness my hand this 26<sup>th</sup> day of January, 1959

\$ 24.90

(State Engineer)

By \_\_\_\_\_  
(Deputy)

GR-1811