


531

Township 59 Range 2 W, W.M.

North

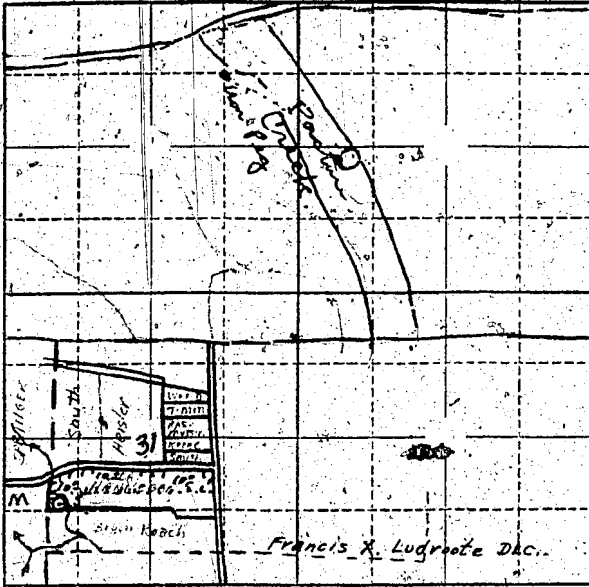

aprox 500 feet from
Road 70 ft from Creek
6.75 from Iron
Road

Locate well and acreage of irrigated land on plat.

Scale 2" = 1 Mile

STATE OF OREGON

County of Marion } ss.

I, Robert Zuchnicki, being first duly sworn, do hereby certify that I have read the foregoing Registration Statement and that all of the items therein contained are true to the best of my knowledge and belief.

Robert Zuchnicki
(Signature of Registrant)

Subscribed and sworn to before me this 7th day of July, 1958.

My commission expires March 11, 1959

J. D. Mason
(Notary Public)

(SEAL)

CERTIFICATE OF REGISTRATION

STATE OF OREGON

County of Marion } ss.

This is to certify that the foregoing Registration Statement was received in the office of the State Engineer on the 8th day of July, 1958, at 8.00 o'clock A. M. and has been duly recorded in said office in Book No. 417 of Registration Statements on page 4095.

Witness my hand this 14th day of July, 1960.

Lewis A. Stanley
(State Engineer)

By _____ (Deputy)

GR 4095