Township 1S Range 4W, W.M.

North

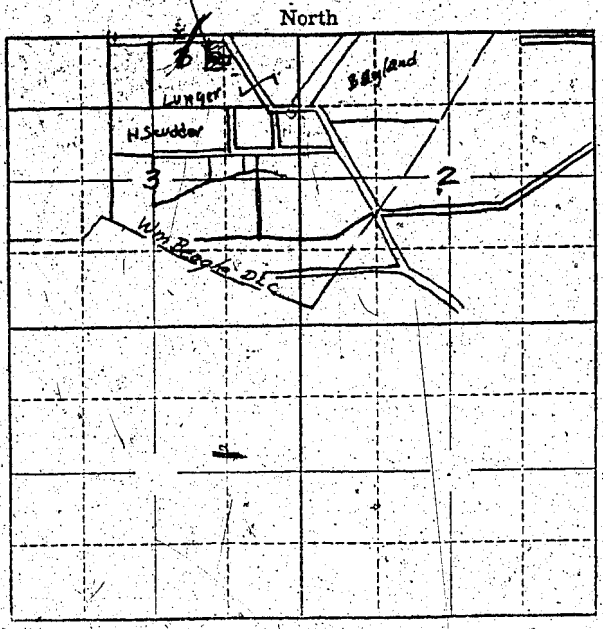

Locate well and acreage of irrigated land on plat.

Scale: 2" = 1 Mile

STATE OF OREGON
County of Washington } ss.

I, Frederick William Lunger being first duly sworn, do hereby certify that I have read the foregoing Registration Statement and that all of the items therein contained are true to the best of my knowledge and belief.

Frederick William Lunger
(Signature of Registrant)

Subscribed and sworn to before me this 25 day of June, 1958

My commission expires Sept 24, 1958 Floyd C Shoop
(Notary Public)

(SEAL)

NOTARY PUBLIC FOR OREGON
My Commission Expires Sept. 24, 1958

CERTIFICATE OF REGISTRATION

STATE OF OREGON
County of Marion } ss.

This is to certify that the foregoing Registration Statement was received in the office of the State Engineer on the 8th day of July, 1958, at 8.00 o'clock A M. and has been duly recorded in said office in Book No. 17 of Registration Statements on page GR-4102

~~Construction shall be completed by ..... 19 ..... and the water completely applied to~~

~~beneficial use by ..... 19 .....~~

Witness my hand this 18th day of October 1960

Lewis A. Stanley
(State Engineer)

$15.00

By .....
(Deputy)

GR-4102