


See attached map.

Township 18S Range 4W, W.M.
North

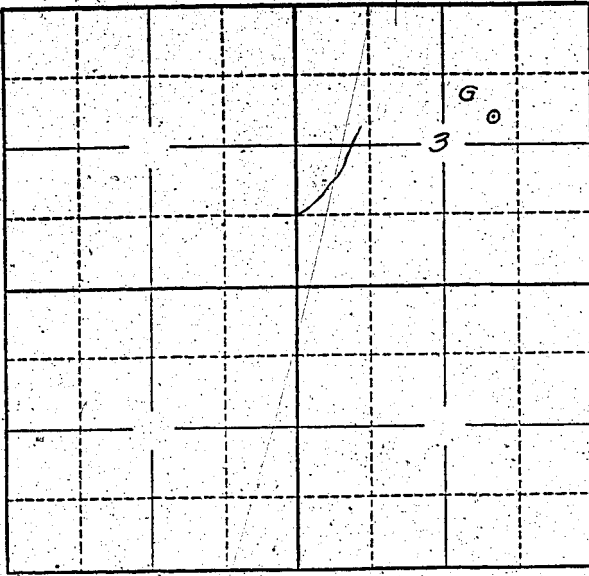

Locate well and acreage of irrigated land on plat.

Scale: 2" = 1 Mile

STATE OF OREGON

County of Lane } ss.

I, Edward I. Pitkin, being first duly sworn, do hereby certify that I have read the foregoing Registration Statement and that all of the items therein contained are true to the best of my knowledge and belief.

Edward I. Pitkin
(Signature of Registrant)

Subscribed and sworn to before me this 24th day of June, 1958

My commission expires January 1, 1959
Robert P. Blanding
(Notary Public)

(SEAL)

CERTIFICATE OF REGISTRATION

STATE OF OREGON }
County of Marion } ss.

This is to certify that the foregoing Registration Statement was received in the office of the State Engineer on the 8th day of July, 1958, at 2:00 o'clock A.M. and has been duly recorded in said office in Book No. 9 of Registration Statements on page GR-1896

Witness my hand this 26th day of January, 1959
Lewis A. Stanley
(State Engineer)

\$1500

By _____ (Deputy)