


Township 1N Range 2W W.M.
North

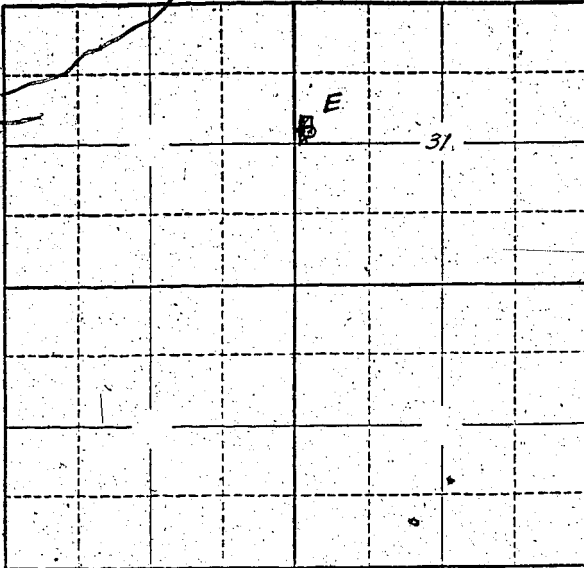

Locate well and acreage of irrigated land on plat.
Scale: 2" = 1 Mile

STATE OF OREGON }
County of Marion } ss.

I, _____, being first duly sworn, do hereby certify that I have read the foregoing Registration Statement and that all of the items therein contained are true to the best of my knowledge and belief.

R C Leonard & Iva Leonard
(Signature of Registrant)

Subscribed and sworn to before me this 7th day of July, 19 58

My commission expires 12th June 1961 Wm S Bartholomew
(Notary Public)

(SEAL)

CERTIFICATE OF REGISTRATION

STATE OF OREGON }
County of Marion } ss.

This is to certify that the foregoing Registration Statement was received in the office of the State Engineer on the 9th day of July, 19 58, at _____ o'clock _____ M. and has been duly recorded in said office in Book No. 9 of Registration Statements on page GR-1912

Witness my hand this 9th day of February, 19 59

\$15.00

[Signature]
(State Engineer)

By _____
(Deputy)