

Locate well and acreage of irrigated land on plat.

Scale: 2" = 1 Mile

STATE OF OREGON

County of Linn } ss.

I, Frank L. and Pansy Richardson, being first duly sworn, do hereby certify that I have read the foregoing Registration Statement and that all of the items therein contained are true to the best of my knowledge and belief.

[Signature]
(Signature of Registrant)

Subscribed and sworn to before me this _____ day of _____, 19____

My commission expires _____
(Notary Public)

(SEAL)

See Page GR-184 K for Certificate
CERTIFICATE OF REGISTRATION

STATE OF OREGON


County of Marion } ss.


Witness my hand this _____ day of _____, 19____

(State Engineer)
By _____
(Deputy)

North

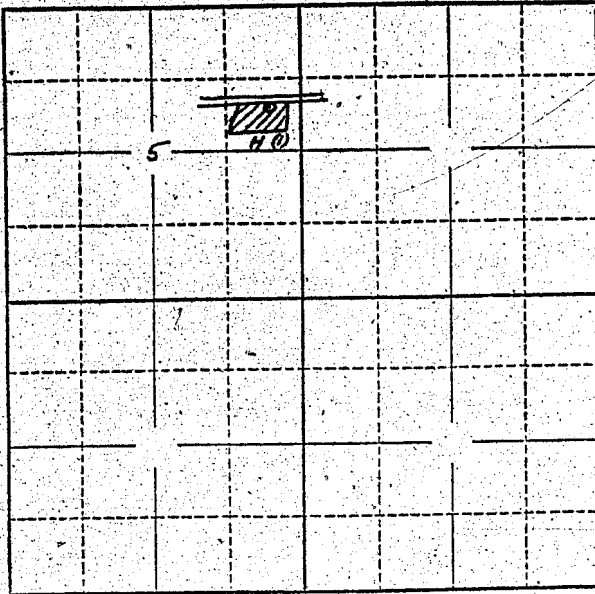

Locate well and acreage of irrigated land on plat.

Scale: 2" = 1 Mile

STATE OF OREGON

County of Linn

ss.

I, Frank L. and Pansy Richardson, being first duly sworn, do hereby certify that I have read the foregoing Registration Statement and that all of the items therein contained are true to the best of my knowledge and belief.

(Signature of Registrant)

Subscribed and sworn to before me this _____ day of _____, 19____

My commission expires _____

(Notary Public)

(SEAL)

See Page GR-181, K for Certificate
CERTIFICATE OF REGISTRATION

STATE OF OREGON

County of Marion

ss.



Witness my hand this _____ day of _____, 19____


(State Engineer)

By _____

(Deputy)

GR-184 G

North

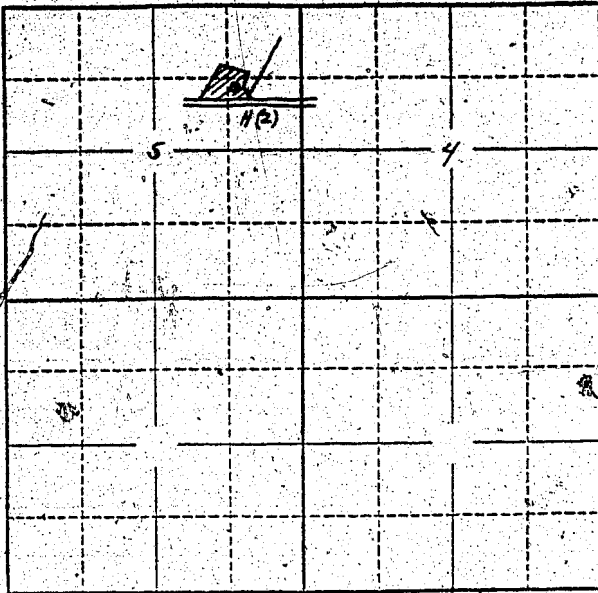

Locate well and acreage of irrigated land on plat.

Scale: 2" = 1 Mile

STATE OF OREGON

County of Linn

} ss.

I, Frank L. and Pansy Richardson, being first duly sworn, do hereby certify that I have read the foregoing Registration Statement and that all of the items therein contained are true to the best of my knowledge and belief.

Frank L. Richardson
Pansy Richardson
(Signature of Registrant)

Subscribed and sworn to before me this 14th day of June, 1956.

My commission expires Sept. 24th, 1956

(Notary Public)

(SEAL)

CERTIFICATE OF REGISTRATION

STATE OF OREGON

County of Marion

} ss.

This is to certify that the foregoing Registration Statement was received in the office of the State Engineer on the 22nd day of June, 1956, at 8 o'clock A. M. and has been duly recorded in said office in Book No. 1 of Registration Statements on page GR-181 K.

Witness my hand this 8th day of October, 1956.

Lewis A. Stanley
(State Engineer)

By

(Deputy)

GR-184 K