


Township 15 Range 2E W.M.

North

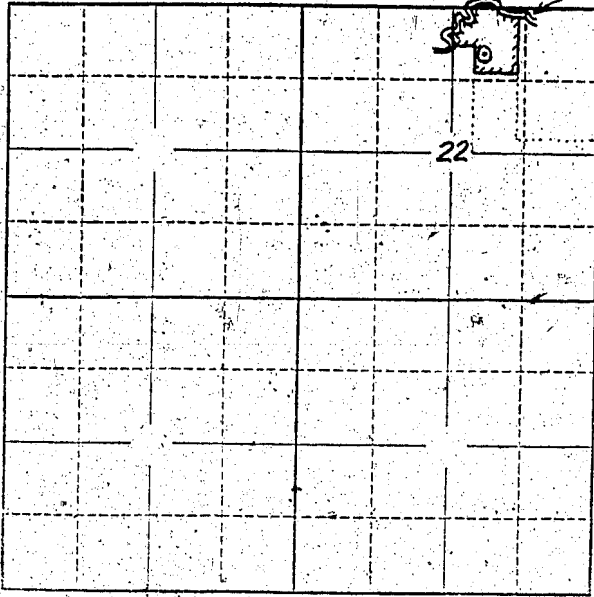

Locate well and acreage of irrigated land on plat.

Scale: 2" = 1 Mile

(Where shown in red being northerly portion of property; and approximate location of well indicated by blue dot.)

STATE OF OREGON

County of Multnomah

ss.

I, Fred T. Heiman,

being first duly sworn, do hereby certify that I have read the foregoing Registration Statement and that all of the items therein contained are true to the best of my knowledge and belief.

Fred T. Heiman  
(Signature of Registrant)

Subscribed and sworn to before me this 7th day of April, 1958.

My commission expires September 3, 1959.

[Signature]  
(Notary Public)

(SEAL)

**CERTIFICATE OF REGISTRATION**

STATE OF OREGON

County of Marion

ss.

This is to certify that the foregoing Registration Statement was received in the office of the State Engineer on the 9th day of July, 1958, at 1:00 o'clock P. M. and has been duly recorded in said office in Book No. 16 of Registration Statements on page GR 3869

~~Construction shall be completed by \_\_\_\_\_, 19\_\_\_\_, and the water completely applied to beneficial use by \_\_\_\_\_, 19\_\_\_\_.~~

Witness my hand this 28th day of December, 1959

[Signature]  
(State Engineer)

By \_\_\_\_\_  
(Deputy)

#1530

GR-3869