


Township 5 S. Range 1 W.M.  
North

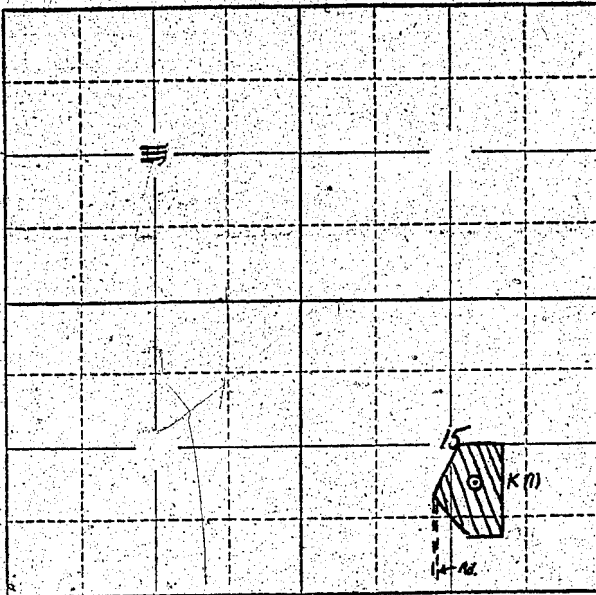

Locate well and acreage of irrigated land on plat.  
Scale: 2" = 1 Mile

STATE OF OREGON }  
County of Marion } ss.

I, W. Earl Dunn, being first duly sworn, do hereby certify that I have read the foregoing Registration Statement and that all of the items therein contained are true to the best of my knowledge and belief.

W. Earl Dunn  
(Signature of Registrant)

Subscribed and sworn to before me this 23rd day of August, 1955.

My commission expires May 24, 1959  
NOTARY PUBLIC FOR OREGON  
My Commission Expires May 24, 1959

[Signature]  
(Notary Public)

**CERTIFICATE OF REGISTRATION**

STATE OF OREGON }  
County of Marion } ss.

This is to certify that the foregoing Registration Statement was received in the office of the State Engineer on the 24th day of August, 1955, at 8:00 o'clock A. M. and has been duly recorded in said office in Book No. 1 of Registration Statements on page GR-77C.

~~Construction shall be completed by 1956 and the water completely applied to beneficial use by 1956.~~

Witness my hand this 12th day of April, 1956.

Lewis A. Stanley  
(State Engineer)

By \_\_\_\_\_ (Deputy)