


North

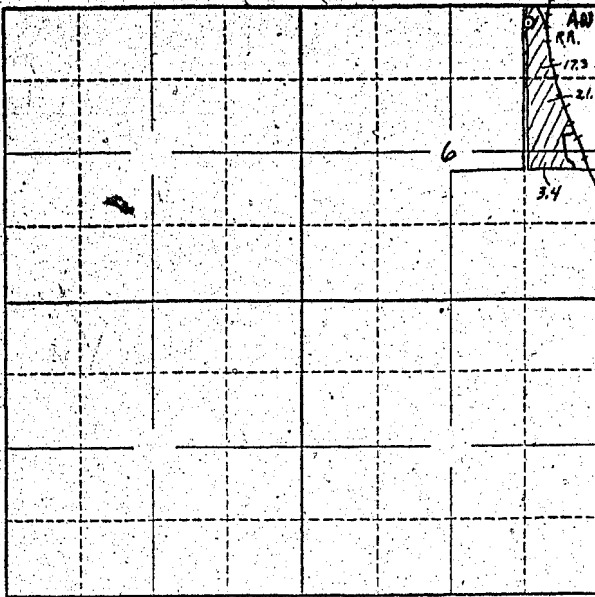

Locate well and acreage of irrigated land on plat.

Scale: 2" = 1 Mile

STATE OF OREGON

County of _____ } ss.

I, _____, being first duly sworn, do hereby certify that I have read the foregoing Registration Statement and that all of the items therein contained are true to the best of my knowledge and belief.

(Signature of Registrant)

Subscribed and sworn to before me this _____ day of _____, 19_____

My commission expires _____

(Notary Public)

(SEAL)

For Certificate of Registration See Page GR-188 G
CERTIFICATE OF REGISTRATION

STATE OF OREGON

County of Marion } ss.

~~This is to certify that the foregoing Registration Statement was received in the office of the State Engineer on the _____ day of _____ 19_____ at _____ o'clock _____ M. and has been duly recorded in the office in Book No. _____ of Registration Statements on page _____~~

~~Construction shall be completed by _____ 19_____ and the water completely installed by _____ 19_____~~

Witness my hand this _____ day of _____, 19_____

(State Engineer)

By _____
(Deputy)

