


Township 12-S Range 4-W W.M.
North

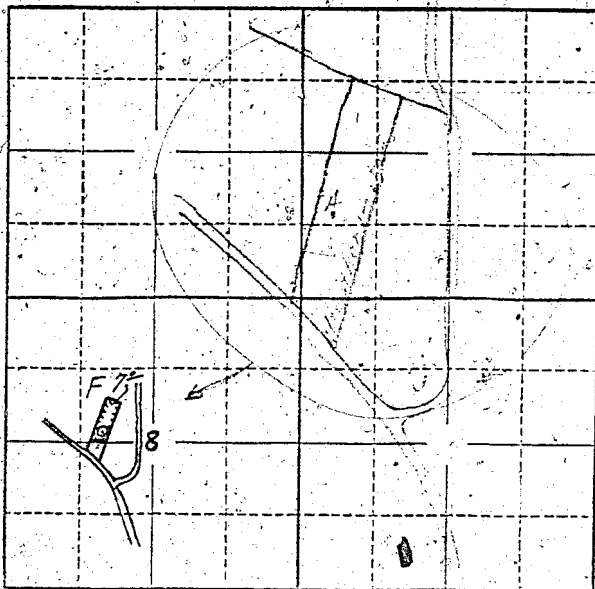

Locate well and acreage of irrigated land on plat.

Scale: 2" = 1 Mile

STATE OF OREGON

County of Benton

SS.

I, Wm D Heatherington, being first duly sworn, do hereby certify that I have read the foregoing Registration Statement and that all of the items therein contained are true to the best of my knowledge and belief.

(Signature of Registrant)

Subscribed and sworn to before me this 19 day of November, 1959

NOTARY PUBLIC FOR OREGON

My commission expires March 29, 1960

(Notary Public)

(SEAL)

This statement is being filed in lieu of the original statement which was filed in this office on July 9, 1956, and was subsequently lost after its return to the owner for completion.

CERTIFICATE OF REGISTRATION

STATE OF OREGON

County of Marion

SS.

This is to certify that the foregoing Registration Statement was received in the office of the State Engineer on the 9th day of July, 1956, at 2:00 o'clock A.M. and has been duly recorded in said office in Book No. 76 of Registration Statements on page OR 3810

Witness my hand this 4th day of December, 1959

(State Engineer)

By

(Deputy)