


Township 55 Range 110 W.M.
North

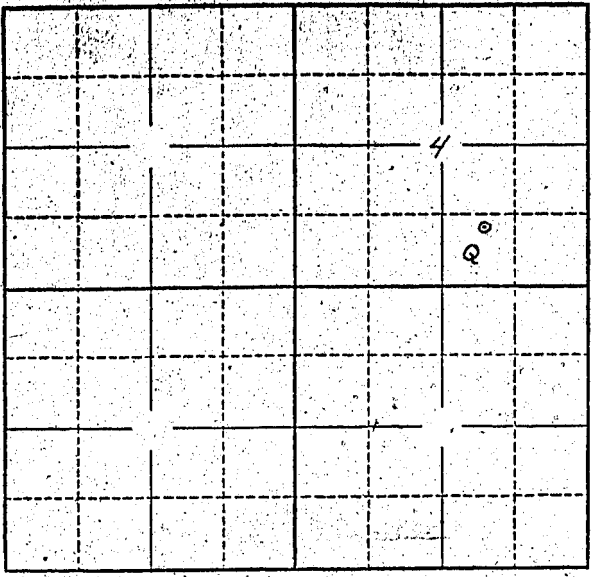

Locate well and acreage of irrigated land on plat.
Scale: 2" = 1 Mile

STATE OF OREGON }
County of Marion } ss.

I, GLEM DRYDEN, being first duly sworn, do hereby certify that I have read the foregoing Registration Statement and that all of the items therein contained are true to the best of my knowledge and belief.

[Signature]
(Signature of Registrant)

Subscribed and sworn to before me this 12th day of July, 1958

My commission expires March 21, 1959
(Notary Public)

(SEAL)

CERTIFICATE OF REGISTRATION

STATE OF OREGON }
County of Marion } ss.

This is to certify that the foregoing Registration Statement was received in the office of the State Engineer on the 14th day of July, 1958, at 2:30 o'clock P. M. and has been duly recorded in said office in Book No. 9 of Registration Statements on page GR-2004

Witness my hand this 9th day of February, 1959

[Signature: Lewis A. Stanley]
(State Engineer)

By _____
(Deputy)

\$15.00