


Township 55 Range 1W, W.M.
North

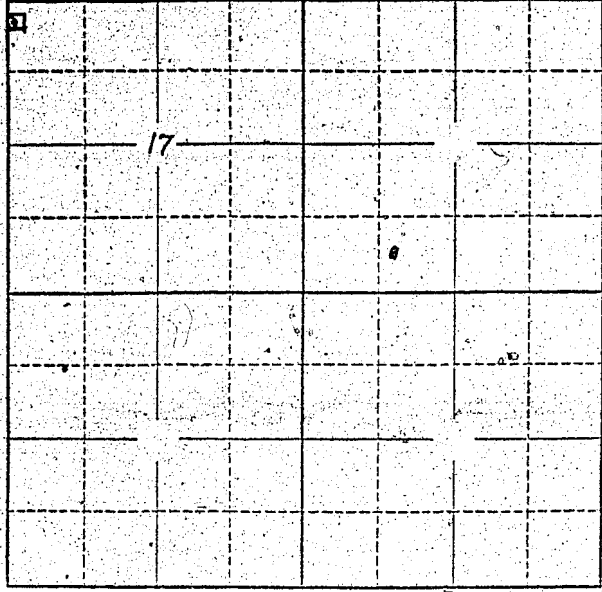

Locate well and acreage of irrigated land on plat.
Scale: 2" = 1 Mile

STATE OF OREGON }
County of Marion } ss.

I, Clyde McRae, being first duly sworn, do hereby certify that I have read the foregoing Registration Statement and that all of the items therein contained are true to the best of my knowledge and belief.

Clyde McRae
(Signature of Registrant)

Subscribed and sworn to before me this 18th day of July, 1956.

My commission expires Sept. 8th, 1956 Chas. A. Sells

(Notary Public)

(SEAL)

CERTIFICATE OF REGISTRATION

STATE OF OREGON }
County of Marion } ss.

This is to certify that the foregoing Registration Statement was received in the office of the State Engineer on the 18th day of July, 1956, at 10 o'clock A.M. and has been duly recorded in said office in Book No. 1 of Registration Statements on page GR-194 C.

~~Construction shall be completed by X-X-X-X-X-X-X-X-X-X-X-X-X-X-X-X and the water completely applied to the field by X-X-X-X-X-X-X-X-X-X-X-X-X-X-X-X.~~

Witness my hand this 23rd day of November, 1956.

Lewis A. Stanley
(State Engineer)

By _____
(Deputy)

GR-194C