


SE 1/4 Section 24

Township 6N Range 35E, W.M.

North

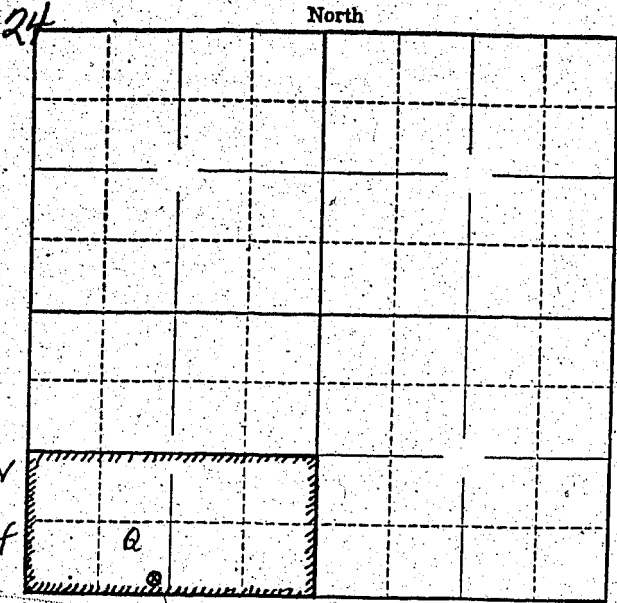

Well location
 621 ft E +
 30 ft N of
 SW cor. of
 SE 1/4 Sec 24
 TWP 6N R 35E

Locate well and acreage of irrigated land on plat.

Scale: 2" = 1 Mile
8"

STATE OF OREGON

County of Umatilla } ss.

I, BLANCHE RANSOM, being first duly sworn, do hereby certify that I have read the foregoing Registration Statement and that all of the items therein contained are true to the best of my knowledge and belief.

Blanche Ransom
 (Signature of Registrant)

Subscribed and sworn to before me this 9th day of July, 1958

My commission expires May 7, 1961

Henry Meyer
 (Notary Public) for Oregon

(SEAL)

CERTIFICATE OF REGISTRATION

STATE OF OREGON } ss.
County of Marion

This is to certify that the foregoing Registration Statement was received in the office of the State Engineer on the 14 day of July, 1958, at 8:00 o'clock A. M. and has been duly recorded in said office in Book No. 9 of Registration Statements on page GR-2016

Witness my hand this 9th day of February, 1959

Clara A. Stanley
 (State Engineer)

By _____ (Deputy)

\$15.00