


North

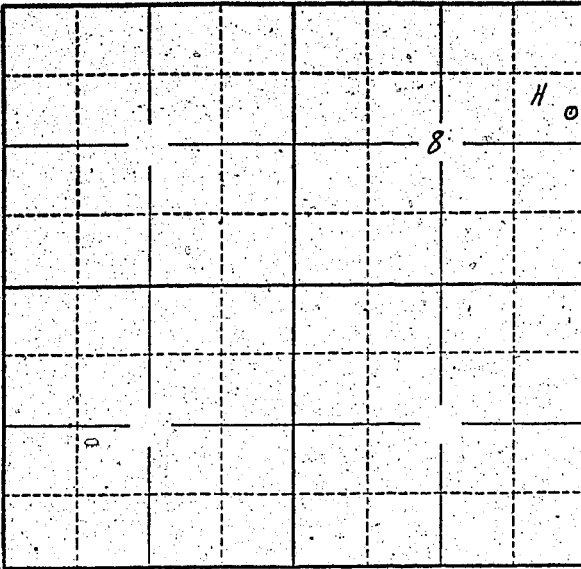

Locate well and acreage of irrigated land on plat.

Scale: 2" = 1 Mile

STATE OF OREGON

County of LINN } ss.

I, Lee And Betty Scott, being first duly sworn, do hereby certify that I have read the foregoing Registration Statement and that all of the items therein contained are true to the best of my knowledge and belief.

Lee Scott Betty Scott
(Signature of Registrant)

Subscribed and sworn to before me this 25 day of June, 1958.

My commission expires January 24, 1961

Mary [unclear]
(Notary Public)

(SEAL)

CERTIFICATE OF REGISTRATION

STATE OF OREGON } ss.
County of Marion

This is to certify that the foregoing Registration Statement was received in the office of the State Engineer on the 14 day of July, 1958, at 8:00 o'clock A. M. and has been duly recorded in said office in Book No. 9 of Registration Statements on page GR-2034

Witness my hand this 16th day of February, 1959
Laura A. Stanley
(State Engineer)

By _____
(Deputy)

\$15.00