Township 7S Range R1W W.M.

North

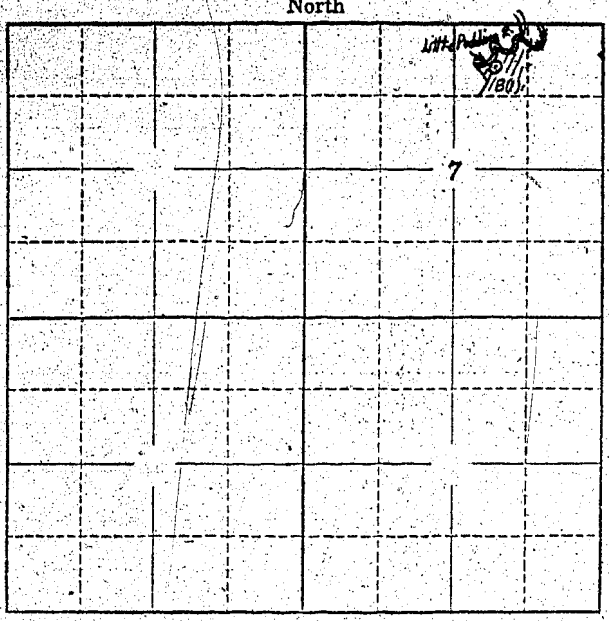

Locate well and acreage of irrigated land on plat.

Scale: 2" = 1 Mile

STATE OF OREGON
County of ..... } ss.

I, David Gering, being first duly sworn, do hereby certify that I have read the foregoing Registration Statement and that all of the items therein contained are true to the best of my knowledge and belief.

David Gering
(Signature of Registrant)

Subscribed and sworn to before me this 20th day of July, 19 56.

My commission expires Sept 8th, 1956

(Notary Public)

(SEAL)

CERTIFICATE OF REGISTRATION

STATE OF OREGON
County of Marion } ss.

This is to certify that the foregoing Registration Statement was received in the office of the State Engineer on the 20th day of July, 19 56, at 8 o'clock A. M. and has been duly recorded in said office in Book No. 1 of Registration Statements on page GR-197 C.

~~Certificate shall be completed by ... and the water ... applied ... by ...~~

Witness my hand this 23rd day of November, 19 56.

Lewis A. Stanley
(State Engineer)

By .....
(Deputy)

GR-197C