


Township 12 S Range 2 W, W.M.
North

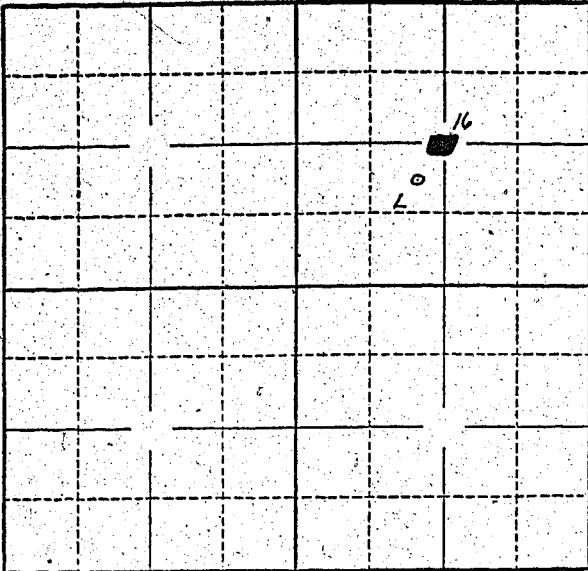

Locate well and acreage of irrigated land on plat.
Scale: 2" = 1 Mile

STATE OF OREGON

County of LINN } ss.

I, John C. Luscher, being first duly sworn, do hereby certify that I have read the foregoing Registration Statement and that all of the items therein contained are true to the best of my knowledge and belief.

John C. Luscher
(Signature of Registrant)

Subscribed and sworn to before me this 3rd day of July, 1958

My commission expires November 27, 1959
Harvey A. Wright
(Notary Public for Oregon)

(SEAL)

CERTIFICATE OF REGISTRATION

STATE OF OREGON

County of Marion } ss.

This is to certify that the foregoing Registration Statement was received in the office of the State Engineer on the 14 day of July, 1958, at 8:00 o'clock A. M. and has been duly recorded in said office in Book No. 9 of Registration Statements on page GR-2040

Witness my hand this 29th day of February, 1959
Lewis A. Stanley
(State Engineer)

By _____ (Deputy)

\$15.00

GR - 2040